



95


Islands in Flat River

Township N<sup>o</sup> 7 N. Range N<sup>o</sup> 8 W. Mer. Mich.

6-16

6-16

Mount Pleasant

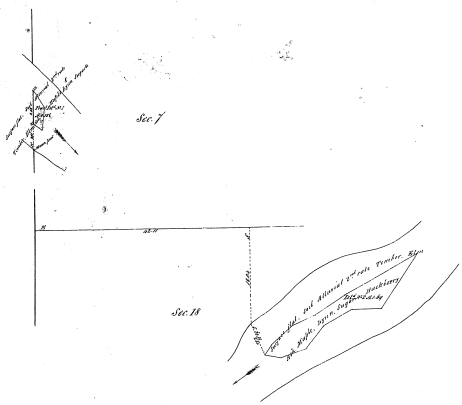

Surveyed by Flat River (under instructions May 20 1857) in 1858

Scale 4 Chains to an inch. No. 1252

The above Map of Township N<sup>o</sup> 7 North of Range N<sup>o</sup> 8 West of the Principal Meridian of Michigan is strictly conformable to the field notes of the Survey thereof on file in this Office which have been examined and approved

Surveyor General's Office  
Detroit April 20<sup>th</sup> 1857

Asst. Surveyor  
Geo. H. ...

1857