


Township N. I south, Range N. III west Mer. (H. Ter.)

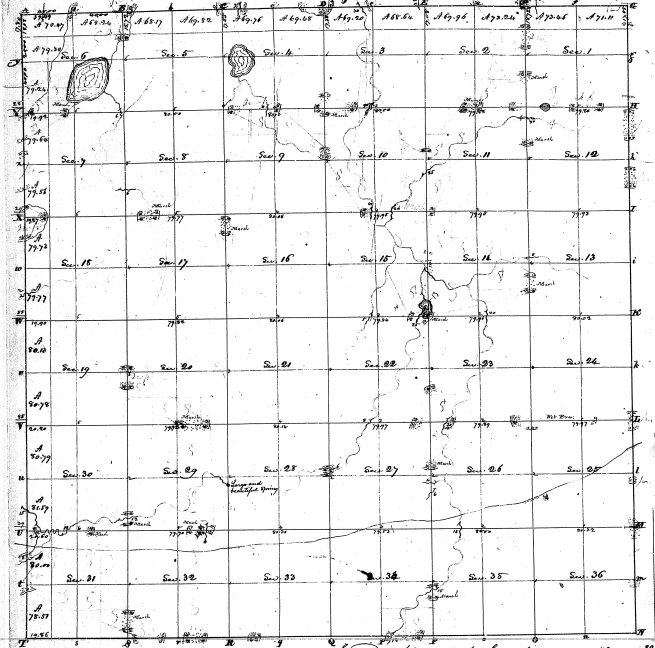

Surveyed in Feb. 1885 by Lewis G. Lyon
Scale one inch to a mile
G. H. O.

3-8

3-8