


Township N IV south, Range N I west Mer. (M. Tm)

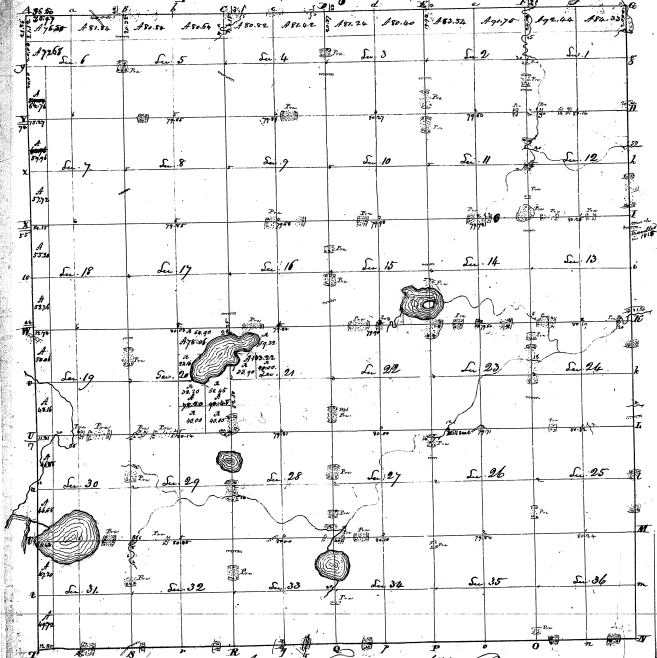

Surveyed in February 1854 by Henry Paul, S. S.

27.661.52
27.661.52

3-31

3-31 (2)

