


Township N. VI North, Range N. IX East of the Meridian (Mich. Ter.)

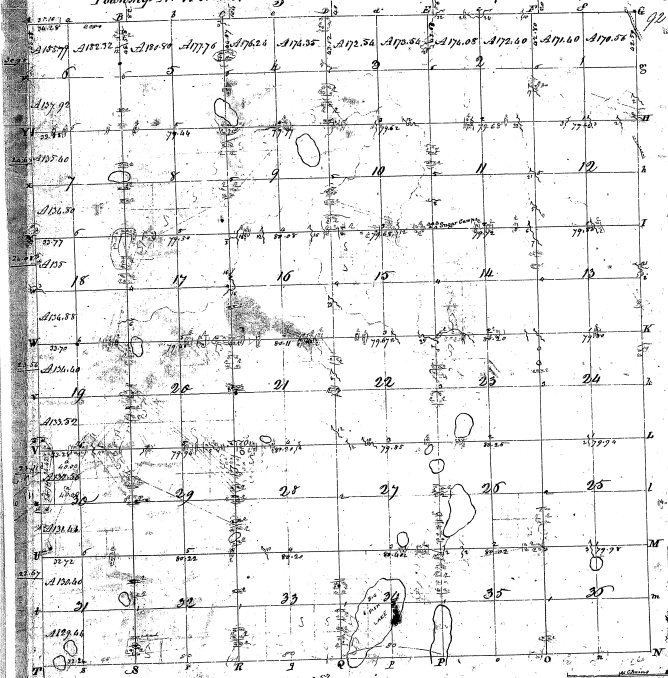

27-17

27-17

Nov. 22, 23, 41, 22

Pursuant to a contract with and instructions from Edward J. Coffin, Surveyor General of the United States, bearing date the 26th day of February in this year 1817, I have administered his oath and surveyed the above described Township, and do hereby certify that it has such marks and bounds, both natural and artificial, as are represented on said plat, and described in the field notes made thereon and returned with the plat into the Surveyor General's Office.
 Certified January 24th 1818.
 Saml. Carpenter, Sr. Surveyor