


Township N. VI North, Range N. III East of Mer. (Mich. Ter.)

112

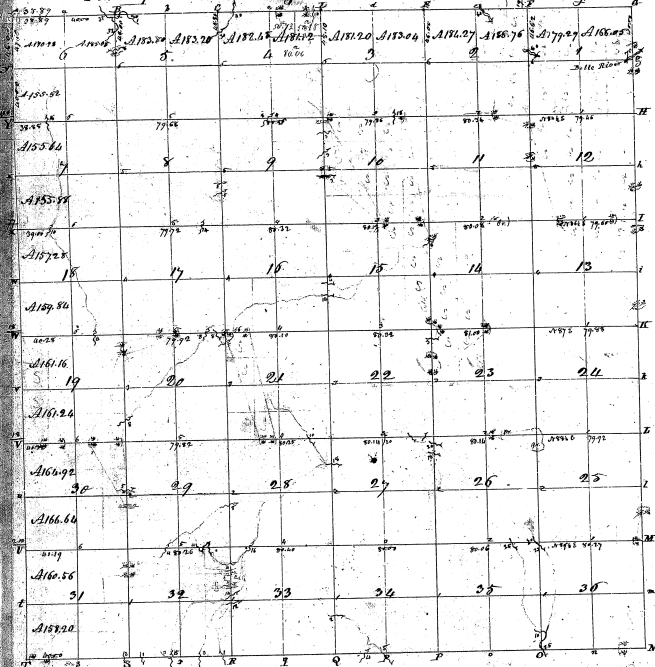

27-20

27-20

Dec. 21, 1852 (187)

Pursuant to a contract with and instructions from Edward T. Fox, Register General of the
 United States bearing date this _____ day of _____
 I have examined laid out and surveyed the above
 described Township and do hereby certify that it has such marks and bounds both natural and artificial as
 are represented on said plat and recorded in the office under more than one name and returned with this plat into
 the Register General's office - Witness this day of _____ 1852

J. H. Hambleton, Esq.