


Township N. III North Range N. V East Mer. (Mch. 20)

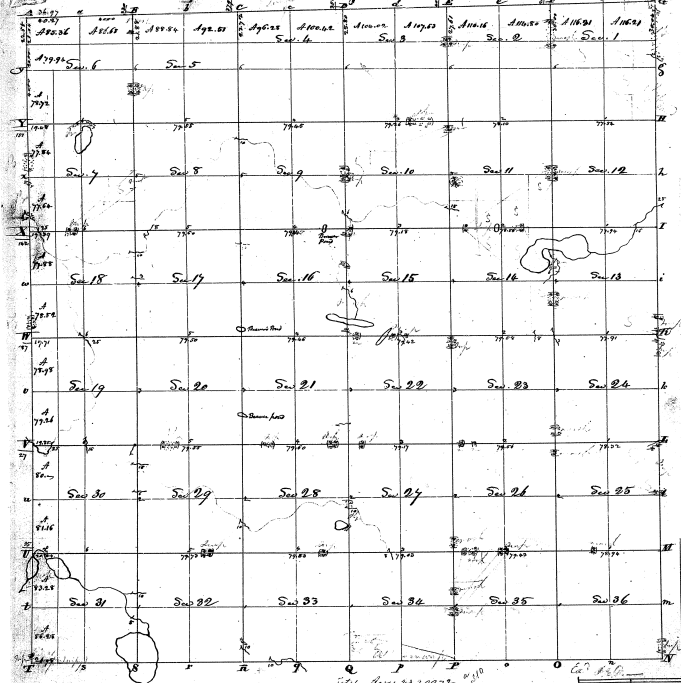

20 32
28-32

Witness my hand and seal this 20th day of October 1897.

P. Deery S. P.