


Township No 13 N Range No 15 West Mer. (Meek.)

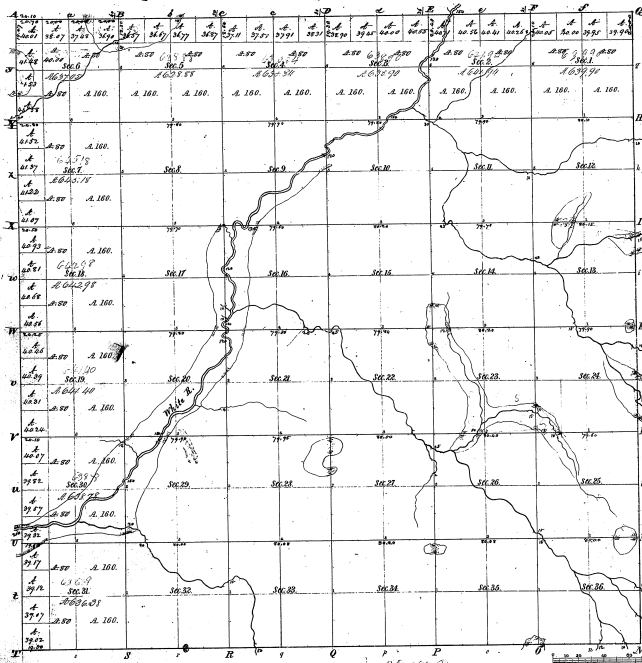

10-31

10-31

Total number of Acres 23,822.23

Survey Designated	By Whom Surveyed	Date of Embark	Amount of Survey	When Surveyed	Area of said land in Acres
Township lines	A. G. S. & J. H. S.	July 1857	77 25	1857	3 1152
Subdivisions	J. H. S.	July 1857	77 25	1857	1 67 1129

The above Map of Township No 13 N. of Range No 15 West Meridian, Meekans is a true and correct copy of the survey thereof on file in this Office, which have been examined and approved.
 Surveyor General's Office
 Cincinnati, Feb 14 1859
 P. S. Seaman, Surveyor