


Township No. 16 North, Range No. 18 West Mer. (Mich.)

Lake Michigan.

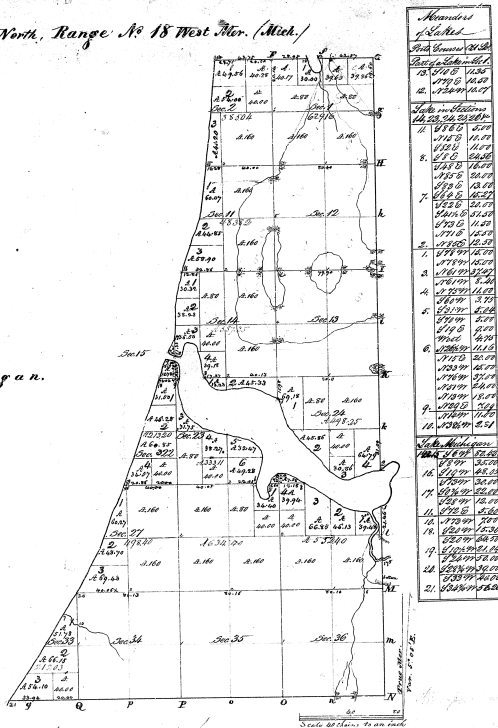

9-9

9-9

Serial number of acres 33 23 32

For Town, Sec. 24, 25, 26, 27, 28, 29, 30, 31, 32, 33, 34, 35, 36, 1838	3
Subdivision, Sec. 16, 1838	33 by 52, 6, 1838 1, 9, 1839

The above Map of Township No. 16 North, Range No. 18 West of the Principal Meridian Michigan is hereby confirmed to the full area of the survey shown on file in this office, which have been examined and approved by the Survey General's Office.

Original, No. 10, 1139

P. C. Pearson

June 20