


Resurvey
Township N^o 17 N. Range N^o 7 W. Mer. Mich.

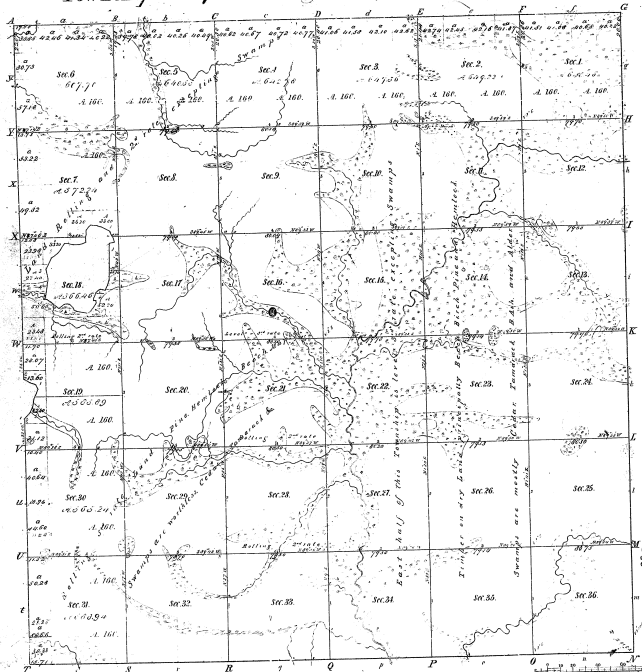

Meridian of	Post Course	BEARINGS	DISTANCES

12-15

Survey designated	By whom Surveyed	Date of Contact	Amount of Survey	When Surveyed	Total number of Acres
Township lines	John Johnson	August 11 1857	36 000 000	Aug. 11 1857	36 000 000
Subdivisions	John & Mellen	Sept 16 1857	36 000 000	Sept. 16 1857	36 000 000
in surveys	Oliver Wagon	April 26 1857	36 000 000	Apr. 26 1857	36 000 000

The above map of Township 17 North of Range 7 West of the Meridian Michigan is strictly conformable to the field notes of the survey shown on file in the Office which have been examined and approved.
 (Signature) Special Officer.
 District May 23 1861