


Re Survey
Township 4th 22^d N **Range 3^d 11th W** **Mer. Mich.**

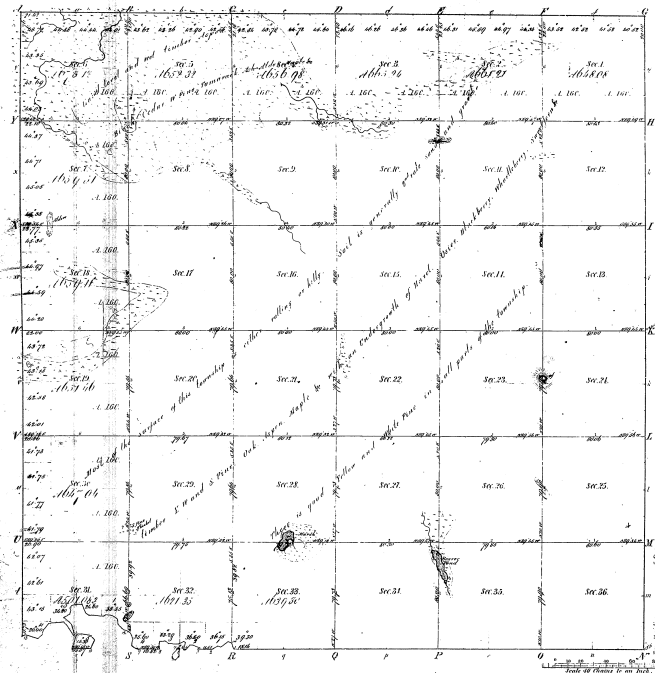

Meridian
 North 0° 0' 0" 1853 1657 31 1657 32 1657 33 1657 34 1657 35 1657 36

14-36

Meridian 3. 12. 57

Total number of Acres 32,255.80

Original Township	By Whom Surveyed	Date of Original	Amount of Survey	When Surveyed	Amount of Survey
Township 4 th 22 ^d N	William Earl	April 22, 1853	2 7/8 3/4	1853	2 7/8 3/4
Subdivision	William Earl	April 22, 1853	63 25 7/8	1853	63 25 7/8

The above copy of Township 4th 22^d North of Range 11th West of the Principal Meridian Michigan is hereby confirmed to the full extent of the survey thereof insofar as that office has been examined and approved.

Survey General Office
 Detroit Feb. 10, 1853

Charles Kettle Surveyor General