


Resurvey
Township N^o 22 N. Range N^o 11 W. Mer. Mich.

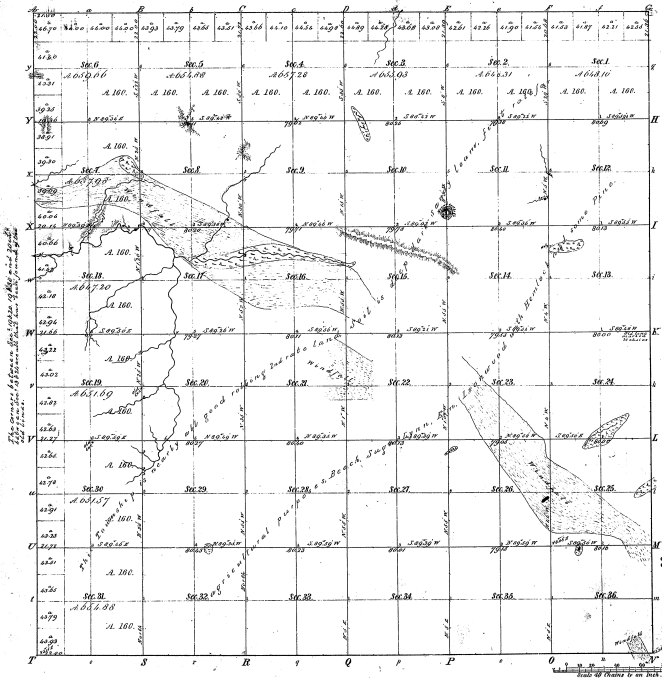

The corner of Section 10, Range 11 West, Township 22 North, is the same as the corner of Section 10, Range 11 West, Township 22 North, Mer. Mich.

Number of	Acres	Acres	Acres	Acres	Acres
Sections	Sections	Sections	Sections	Sections	Sections
16	34				

16-34

Total number of Acres, 22167.56

Survey Designated	By Whom Surveyed	Date of Original	Amount of Survey	When Surveyed	Area in Acres and Cents
Township 22 North	John T. Lyons	Jan. 4, 1856	22 34	1857	22 34
Subdivisions	John T. Lyons	April 16, 1857	66 22	1857	66 22

The above is a copy of the original survey of Range 11 West, Township 22 North, Mer. Mich., as shown on the original map, and is a correct copy of the survey as it appears on the original map, and is approved and approved.

Given Copy made
By J. T. Lyons

Surveyor General's Office
Detroit, Dec. 3, 1887

decius Lyons, Esq., Sec'y.