

REMONUMENTATION

FEB 22 1996

COMMISSION

ALCONA COUNTY REMONUMENTATION
LAND CORNER RECORDATION CERTIFICATE
Filing Requirement of Act 74, Mich. P.A. 1970

Alcona County
Remonumentation
Liber 1 Page 148

For corners in

ALCONA (County)	Located In:	Corner Code #
1. Public Land Survey	T25NR 7E	J-1
	T R	
	T R	
	T R	
2. Property Controlling in Section	S T R	
	S T R	
3. Miscellaneous Property in Sec.	S T R	
	S T R	

APPROVED LAND CORNER
P.A. 345 of 1990
ALCONA COUNTY

Date: 12-20-95
County Rep. ETL

RECORDED

Dec 20 4 49 PM '95

Sonia A. Gauthier
REGISTER OF DEEDS
ALCONA COUNTY MICHIGAN

Register of Deeds Stamp & File Number

4. Lot No. _____, Recorded Plat _____
5. Private Claims _____

I, WILLIAM E. WOODS in a field survey on 12-12- 19 95 do hereby state that under requirements of P.A. 74, Michigan P.A. of 1970, the corner points mentioned in lines 1 and 2 above were in conformance with regulations and rules therefore as required in the current manual of survey instructions of the United States Department of the Interior, Bureau of Land Management or by a decree of a Court of Law and /or that the corner points mentioned in lines 3, 4 and 5 above were in conformance with the rules of the Michigan Board of Land Surveyors or by a Decree of a Court of Law; established, re-established, monumented, recovered, found as expressed below:

NOTE: Not more than 2 corners, all in the same town and range, may be recorded on this certificate.

	A	B	C	D	E	F	G	H	I	J	K	L	M
1													
2		6		5		4		3		2		1	
3													
4		7		8		9		10		11		12	
5													
6		18		17		16		15		14		13	
7													
8		19		20		21		22		23		24	
9													
10		30		29		28		27		26		25	
11													
12		31		32		33		34		35		36	
13													

A. Description of original monument and accessories and/or subsequent restoration:

G.L.O. NO ORIGINAL GOVERNMENT NOTES ON CLOSING CORNERS.


B. Description of corner evidence found and/or method applied in restoring or reestablishing corner:

1928: INDEPENDENT RE SURVEY SET 1" PIPE 36" LONG WITH BRASS CAP.
ELM 4" DIAMETER BEARS S26°E 235 LKS.
POPLAR 5" DIAMETER BEARS S62°30'W 75 LKS.

1965: ROBERT M. PAQUETTE SHOWES NW. CORNER LOT 42 ON FOUR SEASONS NO. 2 A PART OF NE. ¼ OF SECTION 2. T25N, R7E.

C. Description of monument for corner and accessories established to perpetuate locating the position of the corner:

1995: REMONUMENTATION WILLIAM E. WOODS. REMON TO POSITION AS ESTABLISHED
BY R.M. PAQUETTE.
8" W.PINE N53°E 22.28 16" W.PINE S64°W 35.75
5" RED OAK S31°E 42.42 26" TRIPLE ASH N75°W

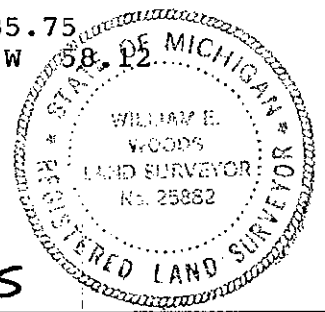

Signed by William E Woods
Surveyor's Michigan License No. 25882

Date 12-20-95