

REMONUMENTATION

APR 24 1995

COMMISSION

1994 Alcona County Remonumentation Corner

Alcona County Remonumentation

Liber 1 Page 91

LAND CORNER RECORDATION CERTIFICATE

Filing Requirement of Act 74, Mich. P.A. 1970 RECORDED

For corners in

Alcona (County)

Located In:

Corner Code

- 1. Public Land Survey T 25N R 9E
2. Property Controlling in Section S T R
3. Miscellaneous Property in Sec. S T R

I/J-7
Other #10

APPROVED LAND CORNER
P.A. 345 of 1990
ALCONA COUNTY

Date: 12-19-94
County Rep: E.J.L.

DEC 21 2 10 PM '94

David A. Smith
REGISTER OF DEEDS
ALCONA COUNTY, MICHIGAN

Register of Deeds Stamp & File Number

- 4. Lot No.
5. Private Claims

Grid table with columns A-L and rows 1-13. A dot is present in row 7, column I.

David B. Guthrie in a field survey on December 20, 1994 do hereby certify that under requirements of P.A. 74, Michigan P.A. of 1970, the corner points mentioned in lines 1 and 2 above were in conformance with regulations and rules therefore as required in the current manual of survey instructions of the United States Department of the Interior, Bureau of Land Management or by a decree of a Court of Law and/or that the corner points mentioned in lines 3, 4 and 5 above were in conformance with the rules of the Michigan Board of Land Surveyors or by a Decree of a Court of Law; established, re-established, monumented, re-monumented, recovered, found as expressed below:

NOTE: Not more than 4 corners, all in the same town and range, may be recorded on this certificate.

A. Description of original monument and accessories and/or subsequent restoration:

- 1843: G.L.O. Survey by Mullett & Burt - Set Post and Referenced W.Pine 16 - N70W - 1.30
1939: Survey by R.J. Cooke - Plat of Greenbush Acres No. 1
1940: Survey by R.J. Cooke - Plat of Huron-Cedar Lakes Sub.


B. Description of corner evidence found and/or method applied in restoring or reestablishing corner:

1994: Found 1" Pipe with NELS Cap

C. Description of monument for corner and accessories established to perpetuate locating the position of the corner:

1994: Replaced with a 5/8" Iron Rod with a 3" Aluminum Cap stamped to identify the Corner. Referenced -

- S06°W - 28" W.Pine - 49.25 Feet
N65°W - 6" W.Pine - 49.32 Feet
S41°W - 4" B.Spruce - 53.35 Feet
N27°W - 15" R.Pine - 107.06 Feet

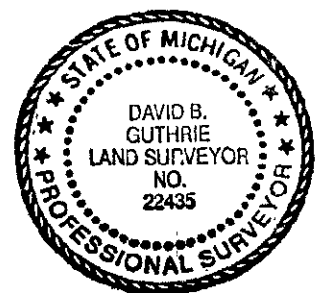

Signed by [Signature]

Date Dec. 21, 1994

Surveyor's Michigan License No. 22435