

REMONUMENTATION

APR 24 1995

COMMISSION

1994 Alcona County Remonumentation Corner

LAND CORNER RECORDATION CERTIFICATE  
Filing Requirement of Act 74, Mich. P.A. 1970

Alcona County  
Remonumentation  
Liber \_\_\_\_\_ Page 96

RECORDED

For corners in

Alcona  
(County)

Located In:

Corner Code #

- 1. Public Land Survey      T 25N R 9E  
  T \_\_\_\_\_ R \_\_\_\_\_  
  T \_\_\_\_\_ R \_\_\_\_\_  
  T \_\_\_\_\_ R \_\_\_\_\_
- 2. Property Controlling    S \_\_\_\_\_ T \_\_\_\_\_ R \_\_\_\_\_  
   in Section                S \_\_\_\_\_ T \_\_\_\_\_ R \_\_\_\_\_
- 3. Miscellaneous            S \_\_\_\_\_ T \_\_\_\_\_ R \_\_\_\_\_  
   Property in Sec.        S \_\_\_\_\_ T \_\_\_\_\_ R \_\_\_\_\_

I/J-13

*Other #12*

APPROVED LAND CORNER  
P.A. 345 101, 1990  
ALCONA COUNTY

Date: 12-21-94  
County Rep: E.T.L.

DEC 21 2 06 PM '94

*Janis A. Guthrie*  
REGISTER OF DEEDS  
ALCONA COUNTY, MICHIGAN

Register of Deeds Stamp & File Number

- 4. Lot No. \_\_\_\_\_, Recorded Plat \_\_\_\_\_
- 5. Private Claims \_\_\_\_\_

	A	B	C	D	E	F	G	H	I	J	K	L
2	6	5	4	3	2	1						
3												
4	7	8	9	10	11	12						
5												
6	18	17	16	15	14	13						
7												
8	19	20	21	22	23	24						
9												
10	30	29	28	27	26	25						
11												
12	31	32	33	34	35	36						

David B. Guthrie in a field survey on December 12, 1994, do hereby certify that under requirements of P.A. 74, Michigan P.A. of 1970, the corner points mentioned in lines 1 and 2 above were in conformance with regulations and rules therefore as required in the current manual of survey instructions of the United States Department of the Interior, Bureau of Land Management or by a decree of a Court of Law and/or that the corner points mentioned in lines 3, 4 and 5 above were in conformance with the rules of the Michigan Board of Land Surveyors or by a Decree of a Court of Law; established, re-established, monumented, re-monumented, recovered, found as expressed below:

**NOTE: Not more than 4 corners, all in the same town and range, may be recorded on this certificate.**

A. Description of original monument and accessories and/or subsequent restoration:

1839: G.L.O. Survey by Lewis Clason - Set Post and Referenced Y.Pine 10 - N43W - 45 / Y.Pine 16 - S64W - 95


B. Description of corner evidence found and/or method applied in restoring or reestablishing corner:

1994: Found Square Concrete Monument

C. Description of monument for corner and accessories established to perpetuate locating the position of the corner:

1994: Capped Concrete Monument with a 3" Aluminum Cap stamped to identify the Corner.

- Referenced -
- N43°W - 12" Cedar - 43.51 Feet
  - N75°W - 10" Cedar - 48.83 Feet
  - S84°W - 6" Maple - 33.88 Feet
  - S59°W - 10" Maple - 42.90 Feet

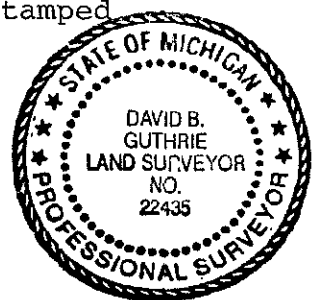

Signed by *D.B. Guthrie*

Date Dec. 21, 1994

Surveyor's Michigan License No. 22435