

SURVEY & REMONUMENTATION

JUL 30 1996

Approved by Alger County
Land Survey Remonumentation
Peer Group Under Act 945 of
P.A. of 1990 On 5/8 1996

Gerald W. Carlson
Chairman

COMMISSION LAND CORNER RECORDATION CERTIFICATE

Filing Requirement of Act 74, Mich. P.A. 1970

4-373

For corners in Alger Located In: _____ Corner Code # _____
(County)

FILED
TIME 3:00 p.m.

- | | | | | | |
|---|---|-----|------|----|--|
| 1. Public Land Survey | T | 48N | R15W | E2 | |
| | T | | R | | |
| | T | | R | | |
| | T | | R | | |
| 2. Property Controlling
In Section | S | T | R | | |
| | S | T | R | | |
| 3. Miscellaneous
Property in Section | S | T | R | | |
| | S | T | R | | |

JUN 27 1996

DONALD W. KINNUNEN
REGISTER OF DEEDS
ALGER COUNTY, MI

Register of Deeds Stamp & File Number

4. Lot No. _____, Recorded Plat _____
5. Private Claims _____

	A	B	C	D	E	F	G	H	I	J	K	L	M
2	6		5		4		3		2		1		
3													
4	7		8		9		10		11		12		
5													
6	18		17		16		15		14		13		
7													
8	19		20		21		22		23		24		
9													
10	30		29		28		27		26		25		
11													
12	31		32		33		34		35		36		
13													

I, Robert L. Jamros, in a field survey on February 19, 1996, 19_____, do hereby certify that under requirements of P.A. 74, Michigan P.A. of 1970, the corner points mentioned in lines 1 and 2 above were in conformance with regulations and rules therefore as required in the current manual of survey instructions of the United States Department of the Interior, Bureau of Land Management or by a decree of a Court of Law and/or that the corner points mentioned in lines 3, 4 and 5 above were in conformance with the rules of the Michigan Board of Professional Surveyors or by a Decree of a Court of Law; established, re-established, monumented, re-monumented, recovered, found as expressed below:

NOTE: Not more than 4 corners, all in the same town and range, may be recorded on this certificate.

A. Description of original monument and accessories and/or subsequent restoration:


E2: PLS-George E. Adair, DS, 1851, Set Qr. section post - Hemlock 8', N.45 E., 13 links, Hemlock 24", S.82 W., 27 links.***** CCI Forestry Division, Land Corner Record, Page 1007, Ray J. Brotherton, RLS, 1952, Set four inch truck spring leaf for monument. BT remains found in both Government BT positions. Notch and portion of scribe marks found in the NE position. Chained 40.30 from Section corner one half mile South. Established the following references, Beech 17", S.48 E., 26 links, Hemlock 13", S.56 1/2 W., 53 links. No other subsequent restoration.

B. Description of corner evidence found and/or method applied in restoring or reestablishing corner:

E2: Found truck spring leaf at corner position. Believed to be iron set by Ray J. Brotherton, RLS, 1952. At 1952 BT locations found witness trees standing and healthy. Upgraded existing BT's to current Alger County standards and established additional reference trees. Set monument at this position alongside spring leaf. Spring leaf position was set from original bearing tree locations and is accepted as a careful and faithful perpetuation of the position of the original corner.

C. Description of monument for corner and accessories established to perpetuate locating the position of the corner:

E2: Placed Berntsen Mon. No. A1NB30 alongside of four inch truck spring leaf, stamped to identify corner position. Renewed existing references trees w/ BT signs and paint. Established additional reference trees w/ BT signs, blazed, scribed and painted. Set PK nails for measure w/ Alum. I.D. washers in the following reference trees. Ex. Beech 28", S.41 E., 17.69 feet, " Dbl. Blzd.", Ex. Hemlock 24", S.61 W., 35.93 feet, " Dbl. Blzd.", W.Pine 14", N.40 W., 33.13 feet, " 1/4s BT ", W.Pine 12", N.70 E., 60.13 feet, " 1/4s BT ", Survey marker sign on six foot steel post, N.40 E., 0.9 feet. All bearings are magnetic.

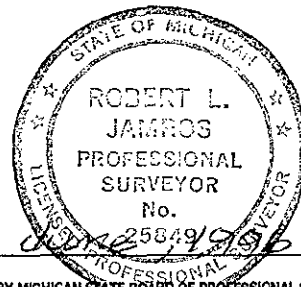

Signed by Robert L. Jamros
Surveyor's Michigan License No. 25849

Date 12 June 1996