

LAND CORNER RECORDATION CERTIFICATE

Filing Requirement of Act 74, Mich. PA 1970

For Corners In:

Arenac _____
(County)

Located In

Corner Code #

1. Public Land Survey T 20N R 3E C12
 T _____ R _____

2. Property Controlling in Section S _____ T _____ R _____
 S _____ T _____ R _____



3. Miscellaneous Property in Section S _____ T _____ R _____
 S _____ T _____ R _____

4. Lot No: _____ Recorded Plat: _____

5. Private Claims: _____

I, Craig W. McVean, in a field survey on June 14, 2005 do hereby state that under requirements of PA 74, Michigan PA of 1970, the corner points mentioned in lines 1 and 2 above were in conformance with regulations and rules therefore as required in the current manual of survey instructions of the United States Department of the Interior, Bureau of Land Management or by a decree of a Court of Law and/or that the corner points mentioned in lines 3, 4 and 5 above were in conformance with the rules of the Michigan Board of Land Surveyors or by a Decree of a Court of Law; established, re-established, monumented, recovered, found as expressed below:

NOTE: Not more than 2 corners, all in the same town and range, may be recorded on this certificate.

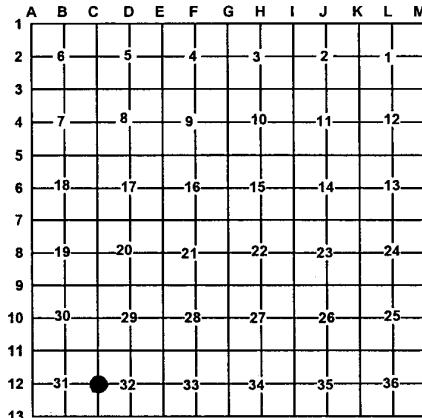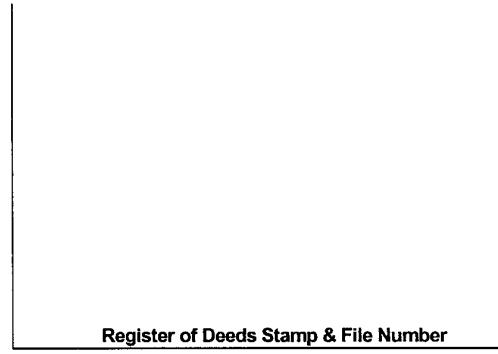

A. Description of original monument and accessories and/or subsequent restoration:

C12 – GLO – Set $\frac{1}{4}$ Post – J. Mullett – 1846

B. Ash 8" N18°W 2 L.

B. Ash 6" S24°E 31 L.

- CCC Notes 1930's – Random S. 120 CH. – Set Random post
- CPC Survey – Drawing #SF16944 – Sheet 97 – 1968

Corner set

B. Description of corner evidence found and/or method applied in restoring or re-establishing corner:

C12 – $\frac{1}{4}$ Corner common to Sec. 31 & 32 – No GLO evidence. No evidence of Consumer's iron. Set 4" DNR Alum. Cap on 1" x 4' long galv. iron pipe by single proportion to GLO between 'C11' & 'C13'. Centerline of intermittent 3-4' wide stream coarse S70°E \pm is North 11' \pm . DNR Mon. accepted as a careful and faithful reestablishment of the position of the original corner.

C. Description of monument for corner and accessories established to perpetuate locating the position of the corner:

C12 – 4" DNR Alum. Cap on 1" x 4' long galv. iron pipe

Set Blue Carsonite Post 1' N

N45°E 41.28' to set N & T in NW side Tw. 18" R. Maple scribed 'XBT'

S27°E 5.47' to set N & T in SW side Tw. 8" R. Maple scribed 'XBT'

N75°W 10.43' to set N & T in S side 11" Ash scribed 'XBT'

S22°W 22.64' to set N & T in E side 12" D. Maple scribed 'XBT'





Signed by:

Craig W. McVean

Surveyor's Michigan License No.:

39088

Date:

9/22/2005

FORM APPROVED BY MICHIGAN STATE BOARD OF PROFESSIONAL SURVEYORS JAN. 28, 1971

Revised May 14, 1975

Revised Jan. 1983

Revised Oct. 1995