

LAND CORNER RECORDATION CERTIFICATE

Filing Requirement of Act 74, Mich. PA 1970

For Corners In:
Arenac _____
(County)

Located In

Corner Code #


1. Public Land Survey T 20N R 3E D11
T _____ R _____
2. Property Controlling in Section S T R
S _____ T _____ R _____
3. Miscellaneous Property in Section S T R
S _____ T _____ R _____

4. Lot No: _____ Recorded Plat: _____

5. Private Claims: _____

I, Craig W. McVean, in a field survey on June 9, 2005 do hereby state that under requirements of PA 74, Michigan PA of 1970, the corner points mentioned in lines 1 and 2 above were in conformance with regulations and rules therefore as required in the current manual of survey instructions of the United States Department of the Interior, Bureau of Land Management or by a decree of a Court of Law and/or that the corner points mentioned in lines 3, 4 and 5 above were in conformance with the rules of the Michigan Board of Land Surveyors or by a Decree of a Court of Law; established, re-established, monumented, recovered, found as expressed below:

NOTE: Not more than 2 corners, all in the same town and range, may be recorded on this certificate.

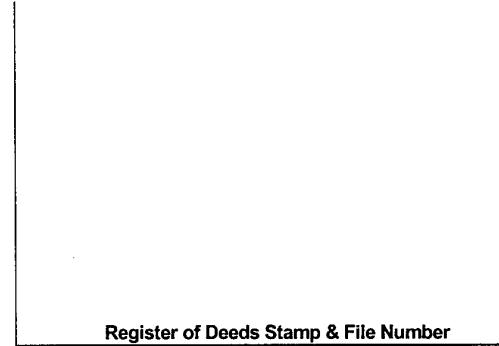

Register of Deeds Stamp & File Number

	A	B	C	D	E	F	G	H	I	J	K	L	M
1													
2	6		5		4		3		2		1		
3													
4	7		8		9		10		11		12		
5													
6	18		17		16		15		14		13		
7													
8	19		20		21		22		23		24		
9													
10	30		29		28		27		26		25		
11													
12	31		32		33		34		35		36		
13													

A. Description of original monument and accessories and/or subsequent restoration:

D11 – GLO – Set $\frac{1}{4}$ Post – J. Mullett – 1846

W. Pine 26" N35°W 40 L.

Hemlock 10" S63°E 64 L.

- CCC Notes – 1930's – Random E. – 116.98 CH. – Old post 84 L. N.

- CPC Survey – Drawing #SF16944 – Sheet 97 – 1968 -

Calc. position only.

B. Description of corner evidence found and/or method applied in restoring or re-establishing corner:

D11 – $\frac{1}{4}$ Corner common to Sec. 29 & 32 – No Conclusive GLO evidence. Didn't find post noted by CCC. CCC seems to have found random post by others but would be too far W to be acceptable. Thus set 4" DNR Alum. Cap on 1" x 36" galv. iron pipe by single proportion to GLO between fd. 'E11' and reestablished 'C11'. DNR Mon. accepted as a careful and faithful reestablishment of the position of the original corner.

C. Description of monument for corner and accessories established to perpetuate locating the position of the corner:

D11 – 4" DNR Alum. Cap on 1" x 36" galv. iron pipe.

Set Blue Carsonite Post 1' N.

S67°E 55.45' to set N & T in NE side 6" W. Pine scribed 'XBT'

N14°E 17.37' to set N & T in E side 7" Oak scribed 'XBT'

S88°W 23.65' to set N & T in S. side 2" W. Pine

CRAIG W. MCVEAN



345 W 19.45' to set in & 1 in SC side of D. Cherry
S81° 45'W 35.99' to Fd. 3/8" rebar – apparent random CPC iron



Signed by:

Craig W. McVean

Surveyor's Michigan License No.:

39088

Date:

9/22/2005

FORM APPROVED BY MICHIGAN STATE BOARD OF PROFESSIONAL SURVEYORS JAN. 28, 1971

Revised May 14, 1975

Revised Jan. 1983

Revised Oct. 1995