

# LAND CORNER RECORDATION CERTIFICATE

Filing Requirement of Act 74, Mich. PA 1970

For Corners In:

Arenac \_\_\_\_\_  
(County)

Located In

Corner Code #

1. Public Land Survey	T _____	R _____	_____	
2. Property Controlling in Section	T _____	R _____	_____	
	S 29	T 20N	R 3E	15
	S 30	T 20N	R 3E	14
3. Miscellaneous Property in Section	S _____	T _____	R _____	
	S _____	T _____	R _____	


4. Lot No: \_\_\_\_\_ Recorded Plat: \_\_\_\_\_

5. Private Claims: \_\_\_\_\_

I, Craig W. McVean, in a field survey on June 15, 2005 do hereby state that under requirements of PA 74, Michigan PA of 1970, the corner points mentioned in lines 1 and 2 above were in conformance with regulations and rules therefore as required in the current manual of survey instructions of the United States Department of the Interior, Bureau of Land Management or by a decree of a Court of Law and/or that the corner points mentioned in lines 3, 4 and 5 above were in conformance with the rules of the Michigan Board of Land Surveyors or by a Decree of a Court of Law; established, re-established, monumented, recovered, found as expressed below:

**NOTE: Not more than 2 corners, all in the same town and range, may be recorded on this certificate.**

Register of Deeds Stamp & File Number

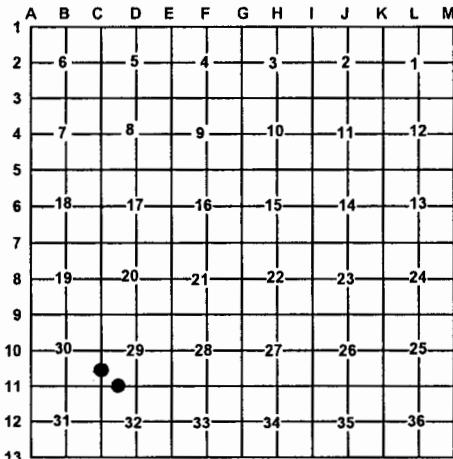

15 - Consumer's Power Co. - Drawing #SF16944, Sheet 96 - 14 - None  
1968 - 'T' iron set with C. P. Co. cap.



B. Description of corner evidence found and/or method applied in restoring or re-establishing corner:

15 - W 1/16 Cor. common to Sec. 29 & 32 - No evidence of Consumer's 'T' iron. Set 2" Alum. Cap on 5/8" x 34" rebar per Standard BLM Procedure. Position on E'ly edge of powerline clearing and is deflection point for Consumer's Fee Strip.

14 - S 1/16 Cor. common to Sec. 29 & 30 - Set 2" Alum. Cap on 5/8" x 34" rebar per Standard BLM Procedure.

C. Description of monument for corner and accessories established to perpetuate locating the position of the corner:

15 - Stamped 2" Alum. Cap on 5/8" x 34" iron rebar. Set Blue Carsonite Post with loc. tag 1' E. N20°E 33.04' to set N & T in E. side 10" R. Maple N68°E 22.07' to set N & T in N. side 8" Ash S17°E 38.94' to set N & T in E. side 10" Ash N86°W 30.33' to set N & T in N. side P. Pole

14 - Stamped 2" Alum. Cap on 5/8" x 34" iron rebar. Set Blue Carsonite Post with loc. tag 1' NE N42°E 32.31' to set N & T in W. side 12" Ash N84°E 27.49' to set N & T in N. side 6" Ash S10°E 63.01' to set N & T in N. side 9" R. Maple S14°E 55.5' to Fd. 2" pipe - Up 5' S64°W 60.75' to set N & T in N. side 8" Elm

Signed by:

Craig W. McVean

Surveyor's Michigan License No.:

39088

Date:

11/30/2005