

LAND CORNER RECORDATION CERTIFICATE
Filing Requirement of Act 74, Mich. P.A. 1970 as Amended

For corners in

Chippewa

(County)

Located In:

Corner Code #

1. Public Land Survey	T45N R 01E	J11
	T R	
	T R	
S 26	T45N R 01E	13
2. Property Controlling	S T R	
in Section	S T R	
3. Miscellaneous	S T R	
Property in Sec.	S T R	

Register of Deeds Stamp & File
Number

4. Lot No. _____, Recorded Plat _____
5. Private Claims

I, Stephan J. Szyszkoski, in a field survey on August 1, 20 07 do hereby state that under requirements of P.A. 74, Michigan P.A. of 1970, the corner points mentioned in lines 1 and 2 above were in conformance with regulations and rules therefore as required in the current manual of survey instructions of the United States Department of the Interior, Bureau of Land Management or by a decree of a Court of Law and /or that the corner points mentioned in lines 3, 4 and 5 above were in conformance with the rules of the Michigan Board of Land Surveyors or by a Decree of a Court of Law; established, re-established, monumented, recovered, found as expressed below:

NOTE: Not more than 2 corners, all in the same town and range, may be recorded on this certificate.

A. Description of original monument and accessories and/or subsequent restoration:

(J11) Quarter corner common to Sections 26 and 35. 1984 - Restored and recorded by D.B.Babbitt RLS: Found old post point in center of abandoned E-W road grade and in line with old fence North. I presume this post point to be the post set by the County Surveyor in his 1907 survey for a "Highway" on the south line of Sec. 26. Set DNR monument. 5" Tamarack S77W 22.3', 6" Tamarack S19E 28.7', 5" Tamarack S35E 30.4', 5" Tamarack S66E 39.3'.

(13-Sec. 26) Southeast 1/16 corner, Section 26. 1984 - Established and recorded by D.B.Babbitt RLS. Set DNR monument. Tag in Fence Post S64W 62.0', Tag in Fence Post S37W 41.4', Tag in Fence Post S3E 37.6', Tag in Fence Post S38W 53.2'.

B. Description of corner evidence found and/or method applied in restoring or reestablishing corner:


(J11) The 1984 monument was not recovered. Reestablished the position for the corner at record bearing and distance from the 1984 NBTs, all recovered in good condition.

(13-Sec. 26) Recovered the 1984 monument in good condition. Could not distinguish the fence posts noted as witnesses in the 1984 record. Found a number of downed posts but no tags were found. Verified the location of the monument by re-subdividing Section 26. Accepted the monument as a careful and faithful establishment of the position of the corner.

C. Description of monument for corner and accessories established to perpetuate locating the position of the corner:

(J11) Set 1"IDx36" I.pipe with plastic cap stamped "MI DNR PS33986". Set measuring nails in the 1984 NBTs:
12" Tamarack S64E 39.6' marked "1/4S"
10" Tamarack S33E 30.65' do
11" Tamarack S16E 28.85' do
12" Tamarack S79W 22.65' do
Bearings are magnetic. Distances are to nail with tag in the side of tree.

(13) Fd. 1"ID I.pipe with 4" alum. cap. Set measuring nails with MDNR tags in the following trees:
7" Tamarack N61E 18.25' mrkd "E1/16 BT"
4" Tamarack N86E 18.2' do
5" Spruce N61W 12.6' do
10" Spruce S35W 51.1' do
Bearings are magnetic. Distances to nail with tag in the side of tree.

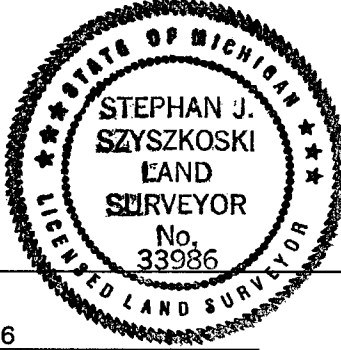

Signed by

Stephan J. Szyszkoski

Date

9/11/07

Surveyor's Michigan License No.

33986

For the Michigan Department of Natural Resources, Office of Land and Facilities

FORM APPROVED BY MICHIGAN STATE BOARD OF PROFESSIONAL SURVEYORS