

Survey &
REMONUMENTATION

JUL 09 1997

COMMISSION

REMONUMENTATION
SECTION 13, OLIVE TOWNSHIP
LAND CORNER RECORDATION CERTIFICATE
Filing Requirement of Act 74, Mich. P.A. 1970

RECORDED
LIBER 4, PAGE 141

For corners in

Clinton
(County)

Located In:

Corner Code #

JUL 9 8 10 AM '96

REGISTER OF DEEDS
CLINTON COUNTY, MICH.
Arden S. Pierson

- | | | | | | |
|------------------------------------|---|-----------|---|-----------|------------|
| 1. Public Land Survey | T | <u>6N</u> | R | <u>2W</u> | <u>L-6</u> |
| | T | | R | | |
| | T | | R | | |
| | T | | R | | |
| 2. Property Controlling in Section | S | | T | | R |
| | S | | T | | R |
| 3. Miscellaneous | S | | T | | R |
| Property in Section | S | | T | | R |

Register of Deeds Stamp & File Number

4. Lot No. _____, Recorded Plat _____
5. Private Claims _____

	A	B	C	D	E	F	G	H	I	J	K	L
2	6		5		4		3		2			
3												
4	7		8		9		10		11		12	
5												
6	18		17		16		15		14			
7												
8	19		20		21		22		23		24	
9												
10	30		29		28		27		26		25	
11												
12	31		32		33		34		35		36	
13												


Arden S. Pierson P.S. in a field survey on September 12, 1995, do hereby certify that under requirements of P.A. 74, Michigan P.A. of 1970, the corner points mentioned in lines 1 and 2 above were in conformance with regulations and rules therefore as required in the current manual of survey instructions of the United States Department of the Interior, Bureau of Land Management or by a decree of a Court of Law and/or that the corner points mentioned in lines 3, 4 and 5 above were in conformance with the rules of the Michigan Board of Professional Surveyors or by a Decree of a Court of Law; established, re-established, monumented, re-monumented, recovered, found as expressed below:

NOTE: Not more than 4 corners, all in the same town and range, may be recorded on this certificate.

A. Description of original monument and accessories and/or subsequent restoration:

Original survey by Hervey Parke DS in 1826. Center of section of Section 13 not set in original survey.

(OVER)

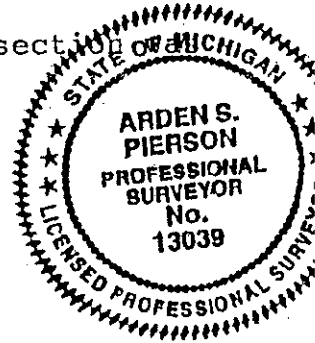

B. Description of corner evidence found and/or method applied in restoring or reestablishing corner:

Found 3/4" pipe buried 18". Accepted 3/4" pipe as the best available evidence of the position of the corner. Replaced with Standard Clinton County Monument and monument box.

(The computed center of section, at the intersection of a line from the opposing 1/4 corners, is N20°32'21"E 4.41 feet from the monumented center of section. The bearing orientation is based on the line from the monumented center of section to the East 1/4 corner, which is assumed to be N90°00'00"E)

C. Description of monument for corner and accessories established to perpetuate locating the position of the corner:

Center, Section 13

- *Standard Clinton County Monument in monument box
- Nail & Tag #13039 in W. Side Wood Anchor Post - S15°W - 26.74'
- Nail & Tag #13039 in E. Side 6" Walnut - N03°W - 35.19'
- Nail & Tag #13039 in W. Side 16" Walnut - N20°W - 48.28'
- Nail & Tag #13039 in SW Side Power Pole - N15°W - 119.70'

*Standard Clinton County Monument is a 2 1/2" dia. steel tube 30" long with a stamped brass cap and a breakaway magnetic base.

Signed by Arden S. Pierson

Date October 16, 1995

Surveyor's Michigan License No. 13039

LCRC Liber 1, Page 811, dated August 20, 1972, by Hathaway Hanes #5260.

Set #6 re-iron
 4" Black Walnut - N50°W - 35.3' - PK Nail
 10" Twin Maple - N30°E - 36.1' - PK Nail
 14" Maple - N50°E - 50.12' - ¼" Pipe

Certified Boundary Survey by Hathaway J. Hanes #5260, dated October 18, 1972, Liber 1, Page 192.

4" Walnut - N5°W - 35.3'
 Twin Maple - N30°E - 36.1'
 ¼" pipe in 14" Maple - N50°E - 50.12'
 Spike and washer

Certified Boundary Survey by Hathaway Hanes #5260 dated December 26, 1973, Liber 1, Page 417.

LCRC Liber 1, Page 627, dated May 18, 1973 by Hathaway Hanes #5260.

Original monument not found.
 Set 3/4" pipe between West ¼ and East ¼ posts.
 4" Walnut - North - 35.37'
 Twin Maple - N30°E - 35.50'
 ¼" Pipe in 14" Maple - N50°E - 48.52'

Certified Boundary Survey by Mark VanRaemdonck #24622, dated August 18, 1987, Liber 3, Page 178.

Found 3/4" pipe
 Nail & tag E. Face 5" Walnut - N05°W - 35.20'
 Nail & tag W. Face 12" Walnut - N15°E - 48.35'
 Nail & tag NW Face 12" Maple - N65°E - 48.00'
 Nail & tag W. Face 18" Poplar - S15°W - 52.52'

Certified Boundary Survey by Mark VanRaemdonck #24622, dated January 27, 1988, Liber 3, Pages 246-247.

Found 3/4" pipe
 Nail & tag E. Face 5" Walnut - N05°W - 35.20'
 Nail & tag W. Face 12" Walnut - N15°E - 48.35'
 Nail & tag NW Face 12" Maple - N65°E - 48.00'
 Nail & tag W. Face 18" Poplar - S15°W - 52.52'

Certified Boundary Survey by Arden Pierson #13039 dated February 21, 1994, Liber 4, Pages 993-994.

Found 3/4" pipe buried 18"
 Wood Anchor Post - S15°W - 26.68'
 Power Pole - N15°W - 119.78'
 6" Walnut - N03°W - 35.23'
 16" Walnut - N17°E - 48.31'

LCRC dated February 23, 1994 by Arden Pierson.

Found 3/4" pipe buried 18".
 Nail & Tag in Wood Anchor Post - S15°W - 26.68'
 Nail & Tag in Power Pole - N15°W - 119.78'
 Nail & Tag in 6" Walnut - N03°W - 35.23'
 Nail & Tag in 16" Walnut - N17°E - 48.31'