

REMONUMENTATION
APR 06 1995
COMMISSION

2-351

LAND CORNER RECORDATION CERTIFICATE
Filing Requirement of Act 74, Mich. P.A. 1970

Boyer Valley Township

For corner in
CHARLEVOIX
 (County)

Located In:	Corner Code #
T <u>32N</u> R <u>5W</u>	<u>A-10</u>
T _____ R _____	_____
T _____ R _____	_____
T _____ R _____	_____
T _____ R _____	_____
S _____ T _____ R _____	_____
S _____ T _____ R _____	_____
S _____ T _____ R _____	_____
S _____ T _____ R _____	_____

STATE OF MICHIGAN
 COUNTY OF CHARLEVOIX
 RECEIVED FOR RECORD

1994 DEC 22 PM 2:24

Charlene M. Cookin
 REGISTER OF DEEDS

Register of Deeds Stamp & File Number

- Public Land Survey
- Property Controlling in Section
- Miscellaneous Property in Sec.

- Lot No. _____, Recorded Plat _____
- Private Claims _____

George J. Avendt, JR. NOV. 16 1994

I, _____, in a field survey on _____, 19____, do hereby certify that under requirements of P.A. 74, Michigan P.A. of 1970, the corner points mentioned in lines 1 and 2 above were in conformance with regulations and rules therefore as required in the current manual of survey instructions of the United States Department of the Interior, Bureau of Land Management or by a decree of a Court of Law and/or that the corner points mentioned in lines 3, 4 and 5 above were in conformance with the rules of the Michigan Board of Land Surveyors or by a Decree of a Court of Law; established, re-established, monumented, re-monumented, recovered, found as expressed below:

NOTE: Not more than 4 corners, all in the same town and range, may be recorded on this certificate.

	A	B	C	D	E	F	G	H	I	J	K	L	M
2	6	5	4	3	2	1							
3													
4	7	8	9	10	11	12							
5													
6	18	17	16	15	14	13							
7													
8	19	20	21	22	23	24							
9													
10	30	29	28	27	26	25							
11													
12	31	32	33	34	35	36							
13													

A. Description of original monument and accessories and/or subsequent restoration:

A-10 QUARTER CORNER COMMON TO SEC. 30, T32, R5W. & SEC. 25, T32N, R6W.
 SURVEYED IN 1839 BY JOHN HODGSON, DS - G.L.O. - HEMLOCK 40" DIAMETER FOR 1/4 POST
 SURVEYED 1975 BY CARL F. ROSER, PS 12028
 FOUND 1/2" REROD AND DROVE 1"X12" PIPE OVER IT; CORNER FALLS IN CENTER OF N-S B'TOP COUNTY ROAD. A CONCRETE U.S.G.S. B.M IS N25°E 83.65'.
 POWER POLE S88°E 29.60 - HI LINE POLE N18°E 192.74 - FOUND 12" T-IRON N86°W 49.50 - 10" POPLAR S62°W 80.7 - SET CEDAR POST DUE E 33' (LIBER 2, PAGE 45)


B. Description of corner evidence found and/or method applied in restoring or reestablishing corner:

A-10 QUARTER CORNER COMMON TO SEC. 30, T32, R5W. & SEC. 25, T32N, R6W.
 FOUND 1" PIPE

Charlevoix Co. Surveyor
APPROVED
 Signature *Mary G. French*
 Date: *Dec 8 1994*
P.A. 345 of 1990

C. Description of monument for corner and accessories established to perpetuate locating the position of the corner:

A-10 QUARTER CORNER COMMON TO SEC. 30, T32, R5W. & SEC. 25, T32N, R6W.
 FOUND 1" PIPE - REPLACED WITH CHARLEVOIX COUNTY MONUMENT.
 N28°E 83.6' 6" U.S.G.S B.M. CONCRETE MONUMENT
 S86°E 29.65' POWER POLE/CAP # 3920
 S57°W 42.25' 4" CEDAR/CAP # 16034
 S86°E 33.30' 6" DNR WITNESS POST
 N82°W 49.49' T-IRON/NO ID CAP
 N55°W 41.05 3" CEDAR/CAP # 16034

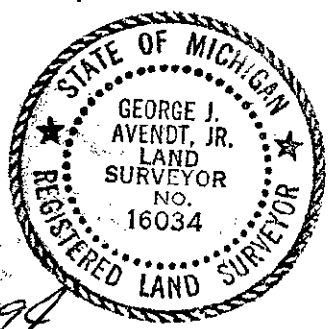

Signed by *George J. Avendt Jr.* Date *8 Dec 1994*
 Surveyor's Michigan License No. 16034