

SURVEY & REMONUMENTATION CHEBOYGAN COUNTY REMONUMENTATION CORNER

MAY 05 1997

LAND CORNER RECORDATION CERTIFICATE
Filing Requirement of Act 74, Mich. P.A. 1970

corners in CHEBOYGAN COMMISSION

Located In:	Corner Code #
(County)	
Public Land Survey	T <u>37N</u> R <u>3W</u> <u>M-3</u>
	T _____ R _____
	T _____ R _____
	T _____ R _____
Property Controlling in Section	S _____ T _____ R _____
Miscellaneous	S _____ T _____ R _____
Property in Sec.	S _____ T _____ R _____

RECEIVED FOR RECORD
96 OCT 30 PM 12:26
James H. Granger
CLERK/REGISTER
CHEBOYGAN COUNTY, MICHIGAN
Register of Deeds Stamp & File Number

Lot No. _____, Recorded Plat _____

Private Claims _____

JAMES H. GRANGER, in a field survey on SEPTEMBER 24, 19 96 hereby state that under requirements of P.A. 74, Michigan P.A. of 1970, the corner points mentioned in lines 1 and 2 above were in conformance with regulations and rules therefore as prescribed in the current manual of survey instructions of the United States Department of the Interior, Bureau of Land Management or by a decree of a Court of Law and /or that the corner points mentioned in lines 3, 4 and 5 above were in conformance with the rules of the Michigan Board of Professional Surveyors or by a Decree of a Court of Law; established, re-established, monumented, re-monumented, found as expressed below:

NOTE: Not more than 2 corners, all in the same town and range, may be recorded on this certificate.

	A	B	C	D	E	F	G	H	I	J	K	L	M
1													
2	6		5		4		3		2		1		
3													
4	7		8		9		10		11		12		
5													
6	18		17		16		15		14		13		
7													
8	19		20		21		22		23		24		
9													
10	30		29		28		27		26		25		
11													
12	31		32		33		34		35		36		
13													


Description of original monument and accessories and/or subsequent restoration:

- 1840 Original Survey John Mullett Set wood post 8" Tamarack N48°W 28 lks 8" Spruce S38°E 4 lks
- 1994 LCRC Norman Quaine #33984 1/2" rod w/cap # 15410

Description of corner evidence found and/or method applied in restoring or reestablishing corner:

Found 1/2" rod with cap # 15410 and four witnesses.

Marcus A. Ross

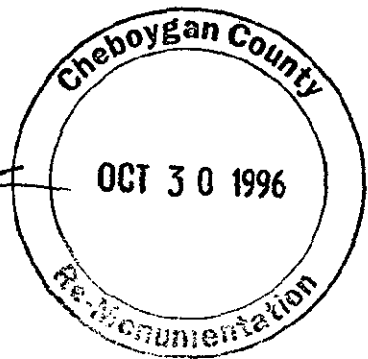


LIBER 010 PAGE 182

Description of monument for corner and accessories established to perpetuate locating the position of the corner.

also corner A-3, T37N, R2W

Set 5/8" x 30" rebar with Remonumentation Cap

2" Rod			
Cedar	S15°W	14.19'	Fd tag
Triple Cedar	N26°W	12.87'	Fd tag
Cedar	N18°E	20.35'	Fd tag
Cedar	N58°E	12.90'	Fd tag

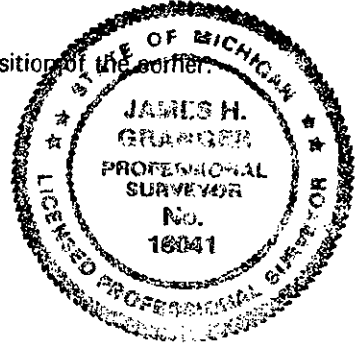

Set by James H. Granger

Date 10-10-96

Surveyor's Michigan License No. 16041