

JAN 25 2000

Approved By Delta County
Land Survey Remonumentation
Peer Group Under Act 345 Of
P.A. Of 1990 On Dec 28, 1999

M. P. Davis
Chairman

SECTION

LAND CORNER RECORDATION CERTIFICATE
Filing Requirement of Act 74, Mich. P.A. 1970

For corners in

DELTA (County)	Located In:	Corner Code #
1. Public Land Survey	T 39 NR 19 W	K-12 ✓
	T 39 NR 19 W	L-07
	T R	
	T R	
	T R	
2. Property Controlling in Section	S T R	
	S T R	
	S T R	
3. Miscellaneous Property in Sec.	S T R	
	S T R	
	S T R	

01-04-00
AT 2:00 O'CLOCK PM
PAGE 9 PAGE 170
REGISTERED

Register of Deeds Stamp & File Number

K-12 [W1/4 COR SEC 36] L-07 [N1/4 COR SEC 24]

- 4. Lot No. _____, Recorded Plat _____
- 5. Private Claims _____

I, M.P. DAVIS, in a field survey on NOVEMBER, 1999 do hereby state that under requirements of P.A. 74, Michigan P.A. of 1970, the corner points mentioned in lines 1 and 2 above were in conformance with regulations and rules therefore as required in the current manual of survey instructions of the United States Department of the Interior, Bureau of Land Management or by a decree of a Court of Law and /or that the corner points mentioned in lines 3, 4 and 5 above were in conformance with the rules of the Michigan Board of Land Surveyors or by a Decree of a Court of Law; established, re-established, monumented, recovered, found as expressed below:

NOTE: Not more than 2 corners, all in the same town and range, may be recorded on this certificate.


	A	B	C	D	E	F	G	H	I	J	K	L	M
1													
2	6		5		4		3		2		1		
3													
4	7		8		9		10		11		12		
5													
6	18		17		16		15		14		13		
7													
8	19		20		21		22		23		24		
9													
10	30		29		28		27		26		25		
11													
12	31		32		33		34		35		36		
13													

A. Description of original monument and accessories and/or subsequent restoration:

- K-12 [W1/4 COR SEC 36] A.MERRYWEATHER,D.S.-1848-WOOD POST (BEECH 12" N40°E 12 LINKS)(SUGAR 07" S83°W 16 LINKS) M.S.McNABB-1946-SET IRON 1/2 DISTANCE BETWEEN CORNERS (CORNER FENCE POST S40°W 50.9')(W.BIRCH 11" S80°W59.0') Wm.F.BOWMAN-1986-L.5 OF LCR'S PG. 280-FOUND IN PLACE AN IRON SPIKE, ID MONUMENT AS THAT SET BY M.S.McNABB FROM BOTH OF HIS BT'S STILL IN PLACE. NOTED NEW BT'S AS W.PINE 12" S35°E 71.3' & W.PINE 8" S32W 61.95'
- L-07 [N1/4 COR SEC 24] A.MERRYWEATHER,D.S.-1848-WOOD POST (SUGAR 12" S60°W 05 LINKS)(SUGAR 06" N60°E 15 LINKS) T.OBRIEN-1982-L.5 OF LCR'S PG.116-SET, BY SINGLE PROPORTIONATE MEASUREMENT, A 1/2" IRON BAR & CAP (PP S52°W 82.15')(APPLE 16" N46°W 63.85') NEIL HILL M.D.O.T.-1989-L.6 OF LCR'S PG.159-FOUND IN PLACE A 1/2" IRON W/A SURVEY CAP, ID CORNER MONUMENT FROM O'BRIENS WIT'S. REPLACED SAME W/A 1/2" REBAR AND CAP AND SET INSIDE A MONUMENT BOX. (APPLE 17" N5°W 43.90')(APPLE 18 N45°E 55.06)(MAPLE 20" SOUTH 152.62')

B. Description of corner evidence found and/or method applied in restoring or reestablishing corner:

- K-12 [W1/4 COR SEC 36] FOUND IN PLACE A 5/8" X 15" IRON PIN. ID CORNER MONUMENT AS THAT BEING SET BY M.S.McNABB IN 1946 FROM BOTH OF Wm. F. BOWMAN'S BT'S WHICH ARE STILL GREEN. ACCEPTED EXISTING MONUMENT AS BEING A CAREFUL & FAITHFUL REESTABLISHMENT OF THE POSITION OF THE ORIGINAL CORNER.
- L-07 [N1/4 COR SEC 24] FOUND IN PLACE AND SET INSIDE A MONUMENT BOX A 1/2" REBAR W/A A RLS CAP. ID MONUMENT AS THAT BEING SET BY NEIL HILL FROM HIS BT'S LISTED AT L.6 OF LCR'S PG. 159. ACCEPTED EXISTING MONUMENT AS BEING A CAREFUL & FAITHFUL REESTABLISHMENT OF THE POSITION OF THE ORIGINAL CORNER.

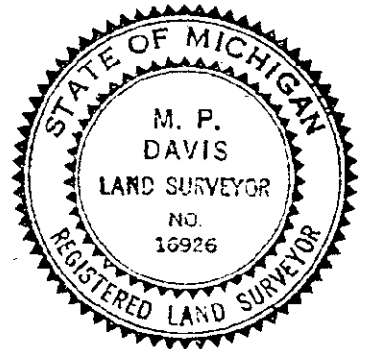

C. Description of monument for corner and accessories established to perpetuate locating the position of the corner:

- K-12 REPLACED EXISTING MONUMENT W/A 5/8" X 18" REBAR W/A 3-1/4" ALUM CAP STAMPED TO ID THE CORNER POSITION.

W.PINE 12"	W.PINE 11"	W.PINE 14"(OLD BT)	W.PINE 11" (OLD BT)		
N37°W	N54°E	S35°E.	S32°W	WEST	
42.43'	68.94'	71.30'	61.95'	31.79'	
- L-07 REPLACED EXISTING RLS CAP W/A 3-1/4" ALUM CAP STAMPED TO ID THE CORNER POSITION.

DRILL HOLES IN LEDGE ROCK				C/L HWY. M-183	
N40°W	N37°E	S29°E	S13°W	SOUTH	
22.80'	17.45'	55.75'	48.10'	16.5'	

NOTE: BEARINGS TO REFERENCE OBJECTS ARE MAGNETIC-DISTANCES ARE TO A NAIL W/A DELTA COUNTY REFERENCE TAG, UNLESS OTHERWISE NOTED.

Signed by M.P. Davis Date 12/20/99
Surveyor's Michigan License No. 16926