

MICHIGAN
DEPARTMENT OF CONSERVATION
FORESTRY DIVISION

LAND CORNER RECORD

T. 42. NR. 27 W..

..... Dickinson COUNTY

DESCRIPTION OF CORNER 1/4 Section Corner between Sections 9 and 16

DESCRIPTION OF CORNER MONUMENT 1" pipe with 4" brass cap,

WITNESSES TO CORNER 8" Sugar Maple S 2° W 8 links

8" Sugar Maple N 43° E 11 links

DESCRIPTION IN DETAIL AS TO HOW CORNER WAS LOCATED AND IDENTIFIED OR RESTORED.


Replaced 1/4 Section Corner between 9 and 16 from original B.T.'s.

One Hemlock B.T. fair condition.

One Hemlock stp. bottom in place.

This 1/4 Corner shown to us by H. S. Peterson, District Forester.

Corner placed and witnessed July 18, 1955.

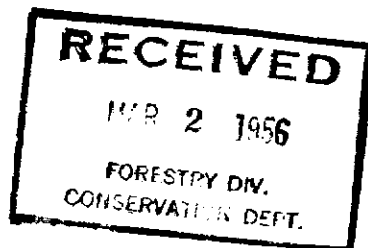

SURVEYORS SEAL

SIGNED Billy D. Buckles DATE 2/27/56
REGISTERED LAND SURVEYOR