

LAND CORNER RECORDATION CERTIFICATE
Filing Requirement of Act 74, Mich. P.A. 1970

For corners in
Houghton

Located in:

Corner Code #

(County)

1. Public Land Survey

T 51N R 35W

D4

T R

T R

2. Property Controlling
in Section

S 8 T 51N R 35W

S T R

S T R

S T R

3. Miscellaneous
Property in Sec.

S T R

4. Lot No. _____, Recorded Plat _____
5. Private Claims _____

9 Sep 04 2003
D4 Sep 03 2003

I, Stephan J. Szyzkoski, in a field survey on _____, 20____ do hereby state that under requirements of P.A. 74, Michigan P.A. of 1970, the corner points mentioned in lines 1 and 2 above were in conformance with regulations and rules therefore as required in the current manual of survey instructions of the United States Department of the Interior, Bureau of Land Management or by a decree of a Court of Law and/or that the corner points mentioned in lines 3, 4 and 5 above were in conformance with the rules of the Michigan Board of Land Surveyors or by a Decree of a Court of Law; established, re-established, monumented, recovered, found as expressed below:

NOTE: Not more than 2 corners, all in the same town and range, may be recorded on this certificate.

(D4) Description of original monument and accessories and/or subsequent restoration:
(D4) Center of Section 8. Not established in the original survey.
(9-Sec. 8) East 1/16 corner, Section 8. Not established in the original survey.

1	A	B	C	D	E	F	G	H	I	J	K	L	M
2	6	5	4	3	2	1							
3													
4	7	8	9	10	11	12							
5													
6	18	17	16	15	14	13							
7													
8	19	20	21	22	23	24							
9													
10	30	29	28	27	26	25							
11													
12	31	32	33	34	35	36							
13													


B. Description of corner evidence found and/or method applied in restoring or reestablishing corner:

(D4) Established the corner at the intersection of straight lines connecting opposite 1/4 corners.
(9-Sec. 8) Established the corner on a straight line between Center of Section 1341.04' West and Quarter corner 1341.04' East.

C. Description of monument for corner and accessories established to perpetuate locating the position of the corner:

(D4) Set 1"IDx32" I. pipe with 4" alum.
MDNR cap. Blazed, scribed, and set
measuring nails in:
6" ELM N21E 19.9' "C1/4 BT"
7" Sugar S79E 22.8' do
4" Spruce S39E 6.2' do
12" Cedar S07W 56.4' do
Set sq'd cedar post adjacent. Bearings
are magnetic. Distances are to nail
with tag.

(9) Set 1"IDx32" I. pipe with 4" alum.
MDNR cap. Blazed, scribed, and set
measuring nails in:
4" Y. Birch N19E 6.65' "1/16S BT"
6" Sugar N83E 35.8' do
11" Hemlock S06W 35.55' do
12" Hemlock S49W 32.1' do
Set sq'd cedar post adjacent. Bearings
are magnetic. Distances are to nail
with tag.

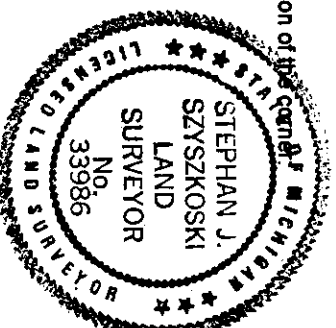

Signed by Stephan J. Szyzkoski
Surveyor's Michigan License No. 33986

Date 9/16/03

For the Michigan Department of Natural Resources - Office of Land and Facilities

FORM APPROVED BY MICHIGAN STATE BOARD OF PROFESSIONAL SURVEYORS, JAN. 28, 1971

REVISED MAY 14, 1975

REVISED JAN. 1983

REVISED OCT. 1985

Register of Deeds Stamp & File Number