

LAND CORNER RECORDATION CERTIFICATE  
Filing Requirement of Act 74, Mich. P.A. 1970

For corners in

Houghton

(County)

Located in:

Corner Code #

1. Public Land Survey

T	R	
T	R	
T	R	
T	R	

2. Property Controlling in Section

S	8	T	51N	R	35W	7
S	8	T	51N	R	35W	6

3. Miscellaneous Property in Sec.

S		T		R	
---	--	---	--	---	--

Register of Deeds Stamp & File Number

4. Lot No. \_\_\_\_\_, Recorded Plat \_\_\_\_\_  
5. Private Claims \_\_\_\_\_

Sep 03 2003

I, Stephan J. Szyszkoski, in a field survey on 20 do hereby state that under requirements of P.A. 74, Michigan P.A. of 1970, the corner points mentioned in lines 1 and 2 above were in conformance with regulations and rules therefore as required in the current manual of survey instructions of the United States Department of the Interior, Bureau of Land Management or by a decree of a Court of Law and/or that the corner points mentioned in lines 3, 4 and 5 above were in conformance with the rules of the Michigan Board of Land Surveyors or by a Decree of a Court of Law, established, re-established, monumented, recovered, found as expressed below:

NOTE: Not more than 2 corners, all in the same town and range, may be recorded on this certificate.

1	A	B	C	D	E	F	G	H	I	J	K	L	M
2		6		5		4		3		2		1	
3													
4		7		8	●	9		10		11		12	
5													
6		18		17		16		15		14		13	
7													
8		19		20		21		22		23		24	
9													
10		30		29		28		27		26		25	
11													
12		31		32		33		34		35		36	
13													

A. Description of original monument and accessories and/or subsequent restoration.  
(7-Sec. 8) North 1/16 corner between Sections 8-9. Not established in the original survey.

(6-Sec. 8) Northeast 1/16 corner, Section 8. Not established in the original survey.

B. Description of corner evidence found and/or method applied in restoring or reestablishing corner.

(7-Sec. 8) Established the corner midway and on a straight line between Section corner 1320.88' North and Quarter corner 1320.88' South.


(6-Sec. 8) Established the corner at the intersection of straight lines connecting opposite 1/16 corners.

C. Description of monument for corner and accessories established to perpetuate locating the position of the corner.

(7-Sec. 8) Set 1"10x32" I. pipe with 4" alum. MDMR cap. Blazed, scribed, and set measuring nails in:	(6) Set 1"10x32" I. pipe with 4" alum. MDMR cap. Blazed, scribed, and set measuring nails in:
4" Y. Birch N05W 12.2' "1/16S 81"	12" Sugar N32W 19.2' "1/16S 81"
6" Maple N86E 9.8' do	11" Maple S74E 6.7' do
6" Maple S55W 7.5' do	7" Y. Birch S15W 9.0' do
11" Maple N82W 17.2' do	4" Sugar S87W 17.8' do

Set sq'd cedar post adjacent. Bearings are magnetic. Distances are to nail with tag.

Set sq'd cedar post adjacent. Bearings are magnetic. Distances are to nail with tag.

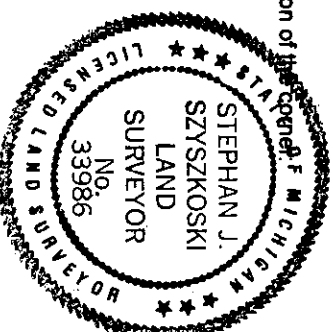

Signed by Stephan J. Szyszkoski  
Surveyor's Michigan License No. 33986

Date 9/16/03

for the Michigan Department of Natural Resources - Office of Land and Facilities

FORM APPROVED BY MICHIGAN STATE BOARD OF PROFESSIONAL SURVEYORS

JAN. 28, 1971  
REVISED MAY 14, 1975  
REVISED JAN. 1983  
REVISED OCT. 1, 1986