

LAND CORNER RECORDATION CERTIFICATE
Filing Requirement of Act 74, Mich. P.A. 1970

For corners in

Houghton
(County) _____ Located in: _____ Corner Code # _____

1. Public Land Survey	T <u>5</u> N <u>R</u> <u>35</u> W	E <u>4</u>
	T <u>5</u> N <u>R</u> <u>35</u> W	E <u>3</u>
	T <u>5</u> N <u>R</u> <u>35</u> W	_____
2. Property Controlling in Section	S <u> </u> T <u> </u> R <u> </u>	_____
3. Miscellaneous Property in Sec.	S <u> </u> T <u> </u> R <u> </u>	_____

Register of Deeds Stamp & File Number													
Sep 03 2003													
1	A	B	C	D	E	F	G	H	I	J	K	L	M
2	6	5	4	3	2	1							
3	7	8	9	10	11	12							
4	18	17	16	15	14	13							
5	19	20	21	22	23	24							
6	30	29	28	27	26	25							
7	31	32	33	34	35	36							
8													
9													
10													
11													
12													
13													

I, Stephan J. Szyszkoski, in a field survey on Sept 03 2003, do hereby state that under requirements of P.A. 74, Michigan P.A. of 1970, the corner points mentioned in lines 1 and 2 above were in conformance with regulations and rules therefore as required in the current manual of survey instructions of the United States Department of the Interior, Bureau of Land Management or by a decree of a Court of Law and/or that the corner points mentioned in lines 3, 4 and 5 above were in conformance with the rules of the Michigan Board of Land Surveyors or by a Decree of a Court of Law, established, re-established, monumented, recovered, found as expressed below:

NOTE: Not more than 2 corners, all in the same town and range, may be recorded on this certificate.

1	A	B	C	D	E	F	G	H	I	J	K	L	M
2	6	5	4	3	2	1							
3	7	8	9	10	11	12							
4	18	17	16	15	14	13							
5	19	20	21	22	23	24							
6	30	29	28	27	26	25							
7	31	32	33	34	35	36							
8													
9													
10													
11													
12													
13													


A. Description of original monument and accessories and/or method applied in restoring or reestablishing corner:
(E4) Quarter corner common to Sections 8-9. 1848; Established by S.W. Higgins; North between Sections 8 & 9...40.00 Set 1/4 Section post. Sugar 16 N23E 8, Sugar 10 S75W 8.

(E3) Corner common to Sections 4-5-8-9. 1959; Billy D. Buckler RLS reestablished this corner at record bearing and distance from an original B.T. Yellow Birch. Set 1" pipe with 4" brass cap. 8" Hard Maple N26W 46 links, 15" Hard Maple N86E 41 links.

B. Description of monument for corner and accessories established to perpetuate locating the position of the corner:

(E4) Set 1" 10x32" 1.pipe with 4" alum. MDNR cap. Blazed, scribed, and set
Measuring nails in: Michigan Dept. of Conservation Cap.

Blazed, scribed, and set meas. nails in:

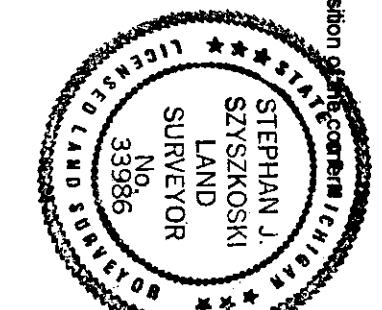

Signed by Stephan J. Szyszkoski, Date 9/16/03
Surveyor's Michigan License No. 33986