

LAND CORNER RECORDATION CERTIFICATE
Filing Requirement of Act 74, Mich. P.A. 1970

SEP 17 1999

For corners in
HOUGHTON
(County)

Located In:

Corner Code #

SECTION

1. Public Land Survey

T 53N R 33W

T 53N R 33W

T _____ R _____

T _____ R _____

2. Property Controlling
in Section

S _____ T _____ R _____

S _____ T _____ R _____

3. Miscellaneous
Property in Section

S _____ T _____ R _____

S _____ T _____ R _____

MEANDER-7 1 1/4 3 Seg. 2
MEANDER-6 1 2/3

MARY SCHOOS 05/04/99 2
HOUGHTON COUNTY, REGISTER 11:02
LC 3/ 580 PAU Fee: 9.00
Page 1 of 1

4. Lot No. _____, Recorded Plat _____

5. Private Claims _____


	A	B	C	D	E	F	G	H	I	J	K	L
2	6		5					4		3		2
3												
4	7		6							10		12
5												
6	18		17							15		13
7												
8	19		20							22		24
9												
10	30		29							27		25
11												
12	31		32							34		36
13												

I, R.W. CRAMPTON, in a field survey on OCTOBER 30, 1998,
do hereby certify that under requirements of P.A. 74, Michigan P.A. of 1970, the corner points mentioned
in lines 1 and 2 above were in conformance with regulations and rules therefore as required in the current
manual of survey instructions of the United States Department of the Interior, Bureau of Land
Management or by a decree of a Court of Law and/or that the corner points mentioned in lines 3, 4 and
5 above were in conformance with the rules of the Michigan Board of Professional Surveyors or by a
Decree of a Court of Law; established, re-established, monumented, re-monumented, recovered, found
as expressed below:

NOTE: Not more than 4 corners, all in the same town and range, may be recorded
on this certificate.

A. Description of original monument and accessories and/or subsequent restoration:

MEANDER-7, SET MEANDER POST ON LEFT BANK (NO WITNESSES)
MEANDER-6, SET MEANDER POST ON RIGHT BANK, NO TREES FOR BEARING

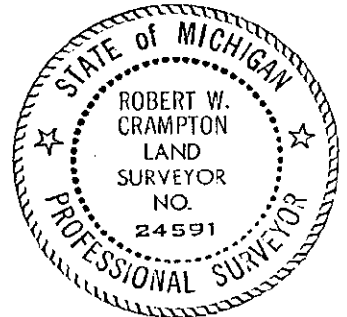

B. Description of corner evidence found and/or method applied in restoring or reestablishing corner:

MEANDER-7, SET 1 1/4" IRON PIPE WITH 2 1/4" BRASS CAP ON LINE BETWEEN SE CORNER AND SW CORNER
OF SECTION 2, 50' FROM THE WATER'S EDGE OF PORTAGE CANAL ON THE WEST BANK.
S89°53'44"E 1600.60' FROM SAID SW CORNER.

MEANDER-6, SET 1 1/4" IRON PIPE WITH 2 1/4" BRASS CAP ON LINE BETWEEN NW MEANDER CORNER ON
WEST SECTION LINE OF SECTION 2 AND THE SW CORNER OF SECTION 2, 100' FROM WATER'S
EDGE OF PORTAGE CANAL ON SOUTH BANK N00°47'36"N 1666.01' FROM SAID SW CORNER.

C. Description of monument for corner and accessories established to perpetuate locating the position of the corner:

MEANDER-7, THE 1 1/4" IRON PIPE WITH BRASS CAP WAS WITNESSED WITH SURVEY TAG NAILED TO:
10" SPRUCE TREE N81°W 133.16', 14" SPRUCE TREE S16°E 193.79',
14" W. BIRCH TREE S28°W 164.82', 14" W. BIRCH TREE S59°W 187.59'.

MEANDER-6, THE 1 1/4" IRON PIPE WITH BRASS CAP WAS WITNESSED WITH SURVEY TAG NAILED TO:
12" W. BIRCH TREE N61°W 19.72', 8" W. BIRCH TREE N02°W 31.46',
12" W. BIRCH TREE S28°W 20.10', 14" W. BIRCH TREE S62°W 22.58'.

Signed by

Robert W. Crampton

Date

MARCH 22, 1999

Surveyor's Michigan License No.

24591