

APPROVED FOR PUBLIC RECORD
P.A. 74, MICHIGAN
Houghton County

SURVEY &
REMONSTRATION

SEP 17 1999

April 22, 1999
Robert W. Crampton

LAND CORNER RECORDATION CERTIFICATE
Filing Requirement of Act 74, Mich. P.A. 1970

For corners in
HOUGHTON
(County)

Located in:

Corner Code #

1. Public Land Survey

T 53N R 33W C 11 MEANDER-13 K 1/2

Seg. 2

T 53N R 33W TL MEANDER-5 I 1/2

2. Property Controlling
in Section

S T R

3. Miscellaneous
Property in Section

S T R

S T R

4. Lot No. _____, Recorded Plat _____

5. Private Claims _____

MARY SCHOOLS 05/04/99 2
HOUGHTON COUNTY, REGISTER 11:00
LC 3/ 578 PAU Fee: 9.00
Page 1 of 1

| A | B | C | D | E | F | G | H | I | J | K | L |
|----|----|----|----|----|----|----|---|---|---|---|---|
| 2 | 6 | 5 | 4 | 3 | 2 | 1 | | | | | |
| 3 | | | | | | | | | | | |
| 4 | 7 | 8 | 9 | 10 | 11 | 12 | | | | | |
| 5 | | | | | | | | | | | |
| 6 | 18 | 17 | 16 | 15 | 14 | 13 | | | | | |
| 7 | | | | | | | | | | | |
| 8 | 19 | 20 | 21 | 22 | 23 | 24 | | | | | |
| 9 | | | | | | | | | | | |
| 10 | 30 | 29 | 28 | 27 | 26 | 25 | | | | | |
| 11 | | | | | | | | | | | |
| 12 | 31 | 32 | 33 | 34 | 35 | 36 | | | | | |
| 13 | | | | | | | | | | | |

I, R.W.CRAMPTON, in a field survey on OCTOBER 22, 1998, do hereby certify that under requirements of P.A. 74, Michigan P.A. of 1970, the corner points mentioned in lines 1 and 2 above were in conformance with regulations and rules therefore as required in the current manual of survey instructions of the United States Department of the Interior, Bureau of Land Management or by a decree of a Court of Law and/or that the corner points mentioned in lines 3, 4 and 5 above were in conformance with the rules of the Michigan Board of Professional Surveyors or by a Decree of a Court of Law; established, re-established, monumented, re-monumented, recovered, found as expressed below:

NOTE: Not more than 4 corners, all in the same town and range, may be recorded on this certificate.

A. Description of original monument and accessories and/or subsequent restoration:


MEANDER-13, SET MEANDER POST, 1334.52' EAST OF SOUTHWEST CORNER OF SECTION 12, SPRUCE 6, N51W 20, Y. BIRCH TREE 10, S60W 14.

MEANDER-5, NOT SET

B. Description of corner evidence found and/or method applied in restoring or reestablishing corner:

MEANDER-13, FOUND 1 1/2" IRON PIPE, FROM SURVEY BY EWART MULLER DATED JULY 1980, AND SURVEY BY U.P. ENGINEERS & ARCHITECTS, INC. DATED 10/26/95.

MEANDER-5, FOUND 6" SQUARE CONCRETE U.S.G.S. MONUMENT FROM CORPS. OF ENGINEERS, NOTE DATED OCT. 19, 1929. IN OLD DOWN FENCE LINE NORTH AND SOUTH. SECTION 12.

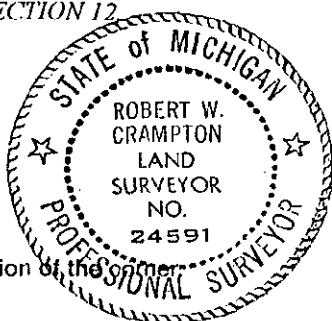

C. Description of monument for corner and accessories established to perpetuate locating the position of the corner:

MEANDER-13 LEFT 1 1/2" IRON PIPE IN PLACE, AND PLACED 2 1/4" BRASS CAP. FOUND BRASS TAGS (U.P. ENG. #18983) NAILED TO 10" W. PINE TREE S52°E 22.37', 10" W. PINE TREE S41°W 17.61', 7" W. PINE TREE N80°W 16.83', 8" W. PINE TREE N59°W 9.36'.

MEANDER-5 LEFT MONUMENT IN PLACE, PLACED 1 1/4" IRON PIPE WITH 2 1/4" BRASS CAP NEXT TO MONUMENT. WITNESSED WITH SURVEY TAG NAILED TO: 8" ASPEN TREE N37°W 28.26', 6" HEMLOCK TREE N31°E 18.42', 5" BALSAM TREE S49°E 16.28', 14" H. MAPLE TREE S46°W 14.23',

Signed by Robert W. Crampton Date MARCH 22, 1999
Surveyor's Michigan License No. 24591