

Re-Mon, Liber 1, Page 167

REMONUMENTATION

LAND CORNER RECORDATION CERTIFICATE
Filing Requirement of Act 74, Mich. P.A. 1970

For corners in

<u>Huron</u> (County)	Located in:	Corner Code #
1. Public Land Survey	Rubicon T17N R15E	F-13
	T R	
	T R	
	T R	
2. Property Controlling in Section	S T R	
	S T R	
3. Miscellaneous Property in Sec.	S T R	
	S T R	

STATE OF MICHIGAN
HURON COUNTY
RECORDED

25 NOV 98 10:06 A.M.

FRANCES L. HOLDWICK
REGISTER OF DEEDS

Register of Deeds Stamp & File Number

4. Lot No. _____, Recorded Plat _____
5. Private Claims _____

I, Charles S. Getz, in a field survey on Nov. 12, 1998 do hereby state that under requirements of P.A. 74, Michigan P.A. of 1970, the corner points mentioned in lines 1 and 2 above were in conformance with regulations and rules therefore as required in the current manual of survey instructions of the United States Department of the Interior, Bureau of Land Management or by a decree of a Court of Law and /or that the corner points mentioned in lines 3, 4 and 5 above were in conformance with the rules of the Michigan Board of Land Surveyors or by a Decree of a Court of Law; established, re-established, monumented, recovered, found as expressed below:

NOTE: Not more than 2 corners, all in the same town and range, may be recorded on this certificate.

	A	B	C	D	E	F	G	H	I	J	K	L	I
1													
2	6		5		4		3		2		1		
3													
4	7		8		9		10		11		12		
5													
6	18		17		16		15		14		13		
7													
8	19		20		21		22		23		24		
9													
10	30		29		28		27		26		25		
11													
12	31		32		33		34		35		36		
13													

A. Description of original monument and accessories and/or subsequent restoration:

F-13
1834 G.L.O., H. Parke D.S.
Set quarter section post
Cedar 10", N77°W, 24 1/2 Links
Hemlock 5", N23°W, 36 Links

County Surveyor Records - NONE
County Road Commission Records - Iron Pin
Recorded Surveys - NONE
Unrecorded Surveys - NONE

L.C.R.C. - NONE

B. Description of corner evidence found and/or method applied in restoring or reestablishing corner:

F-13
S 1/4 Cor, Section 33, T17N-R15E
Found no evidence of original corner position.
Re-established corner position by proportionate measure from G.L.O. Notes, between G-13 and E-13 as best evidence of original corner position for F-13.
(On Rapson Road)


SURVEY &
REMONUMENTATION

JAN 28 1999

SECTION

C. Description of monument for corner and accessories established to perpetuate locating the position of the corner:

F-13
S 1/4 Cor, Section 33, T17N-R15E
Set 1/2" Re-Rod (Capped)
North 36.40' to Nail in Fence Post
N30°E 47.70' to Nail in 18" Pine
S10°W 39.55' to Telephone Box
S40°W 48.00' to Nail in 12" Poplar
West 2636.78' to SW Cor, Sec 33, T17N-R15E
East 2636.78' to SE Cor, Sec 33, T17N-R15E

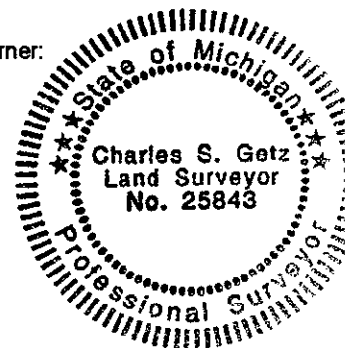

Signed by Charles S. Getz
Surveyor's Michigan License No. 25843

Date November 15, 1998

PEER GROUP APPROVED AT
MEETING 11-24-98 RJB