

LAND CORNER RECORDATION CERTIFICATE
Filing Requirement of Act 74, Mich. P.A. 1970

For corners in

Iron

 (County)

Located in: Corner Code #

1. Public Land Survey	T _____ R _____	_____
	T _____ R _____	_____
	T _____ R _____	_____
	T _____ R _____	_____
2. Property Controlling in Section	S 12 T 44N R 33W	6
	S 12 T 44N R 33W	7
3. Miscellaneous Property in Sec.	S _____ T _____ R _____	_____
	S _____ T _____ R _____	_____

Register of Deeds Stamp & File Number

4. Lot No. _____, Recorded Plat _____
 5. Private Claims _____

Aug 13 2002

I, Stephan J. Szyszko, in a field survey on _____, 2000 do hereby state that under requirements of P.A. 74, Michigan P.A. of 1970, the corner points mentioned in lines 1 and 2 above were in conformance with regulations and rules therefore as required in the current manual of survey instructions of the United States Department of the Interior, Bureau of Land Management or by a decree of a Court of Law and/or that the corner points mentioned in lines 3, 4 and 5 above were in conformance with the rules of the Michigan Board of Land Surveyors or by a Decree of a Court of Law; established, re-established, monumented, recovered, found as expressed below:

NOTE: Not more than 2 corners, all in the same town and range, may be recorded on this certificate.

	A	B	C	D	E	F	G	H	I	J	K	L	M
1													
2	6		5		4		3		2		1		
3													
4	7		8		9		10		11		12		
5													
6	18		17		16		15		14		13		
7													
8	19		20		21		22		23		24		
9													
10	30		29		28		27		26		25		
11													
12	31		32		33		34		35		36		
13													

A. Description of original monument and accessories and/or subsequent restoration:

(6-Sec. 12) Northeast 1/16 corner, Section 12. Not established in the original survey.

(7-Sec. 12) North 1/16 corner between Section 12 T44N-R33W and Section 7 T44N-R32W. Not established in the original survey.


B. Description of corner evidence found and/or method applied in restoring or reestablishing corner:

(6-Sec. 12) Established the corner at the intersection of straight lines connecting opposite 1/16 corners.

(7-Sec. 12) Established the corner midway and on a line of mean true bearing between Section and Quarter corners of record 1316.05' north and south.

C. Description of monument for corner and accessories established to perpetuate locating the position of the corner:

(6) Set 1"IDx32" I.pipe with 4" alum. MDNR cap. Blazed and scribed: 9" B.Spruce N19E 14.9' "1/16S BT"	(7) Set 1"IDx32" I.pipe with 4" alum. MDNR cap. Blazed and scribed: 4" B.Spruce N51E 20.6' "1/16S BT"
7" Tamarack S87E 30.6' do	5" B.Spruce S40E 13.9' do
6" B.Spruce S01E 27.4' do	9" B.Spruce S06W 20.0' do
8" Tamarack N67W 22.6' do	8" B.Spruce N82W 29.7' do
Set Sq'd B.Spruce post adjacent.	Set sq'd cedar post adjacent. Bearings
Bearings are magnetic. Distances are to	are magnetic. Distances are to notch in
notch in lower blaze.	lower blaze.

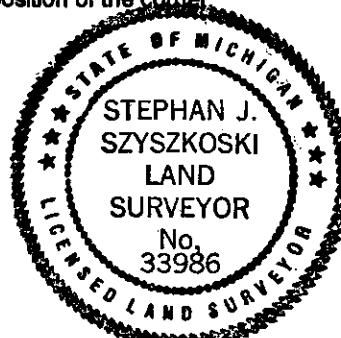

Signed by Stephen J. Szyszko
 Surveyor's Michigan License No. 33986

Date 8/19/02