

## REMONUMENTATION

MAR 08 1999

## SECTION

For corners in

Kent  
(County)LAND CORNER RECORDATION CERTIFICATE  
Filing Requirement of Act 74, Mich. P.A. 1970  
KENT COUNTY REMONUMENTATION

Located in: Grattan Township Corner Code #

1. Public Land Survey      T 8N      R 9W      E-3S  
                                     T      R  
                                     T      R      Witness Monument  
                                     T      R

2. Property Controlling in Section      S            T            R        
                                     S            T            R      

3. Miscellaneous Property in Sec.      S            T            R        
                                     S            T            R      

4. Lot No.      , Recorded Plat        
 5. Private Claims      

I, Randy Kolehouse, in a field survey on March 24 1998, do hereby certify that under requirements of P.A. 74 Michigan P.A. of 1970, the corner points mentioned in lines 1 and 2 above were in conformance with regulations and rules therefore as required in the current manual of survey instructions of the United States Department of the Interior, Bureau of Land Management or by a decree of a Court of Law and/or that the corner points mentioned in lines 3, 4 and 5 above were in conformance with the rules of the Michigan Board of Land Surveyors or by a Decree of a Court of Law; established, re-established, monumented, re-monumented, recovered, found as expressed below:

**NOTE: Not more than 4 corners, all in the same town and range, may be recorded on this certificate.**

## A. Description of original monument and accessories and/or subsequent restoration:

E-3	1837      G.L.O. Notes	Cathcart	Meander Corner
1993      L.C.R.C. #6778	Thomas Starr	Set K.C. Witness Monument	
1995      L.C.R.C. #8012	Glaza & Associates	K.C. Witness Monument	

A	B	C	D	E	F	G	H	I	J	K	L	M
2	6	5	4	3	2	1						
3			●									
4	7	8	9	10	11	12						
5												
6	18	17	16	15	14	13						
7												
8	19	20	21	22	23	24						
9												
10	30	29	28	27	26	25						
11												
12	31	32	33	34	35	36						
13												

P.A. 345 1990 KENT COUNTY  
 PEER APPROVED 6/25/98  
 CHAIRMAN Randy Kolehouse

This corner was originally approved by the Kent County Remonumentation Peer Group and monumented by Thomas Starr on 3/15/98 and was recorded per L.C.R.C. #6778.

## B. Description of corner evidence found and/or method applied in restoring or reestablishing corner:

E-3 Found a Standard Kent County Witness Monument on the South side of Muskrat Lake 200' ± South of the South edge of Muskrat Lake per L.C.R.C.'s #6778 and #8012 as set by Thomas Starr 1900.00' North of E-4.

L.C.R.C. #6778

L.C.R.C. #8012

Nail & Tag in N. side 12" Ash N 85° W 10.64'  
 Nail & Tag in N. side 14" Ash N 50° W 15.97'  
 Nail & Tag in E. side Twin 12" Mapale N 15° W 23.10'  
 Nail & Tag in W. side 16" Oak N 15° E 14.43'  
 Nail & Tag in S. side 6" Maple N 80° E 4.65'  
 Nail & Tag in W. side 12" Maple Due South 21.90'

Nail & K.C. remon tag in N side 12" Ash N 85° W 10.62'  
 Nail & K.C. remon tag in N side 14" Ash N 50° W 15.95' (m. 15.97')  
 Nail & K.C. remon tag in E side 12" Twin Maple N 15° W 23.08' (23.08')  
 Nail & K.C. remon tag in W side 18" Oak N 15° E 14.43' (m. 14.44')  
 Nail & K.C. remon tag in S side 6" Maple N 80° E 4.70' (m. 4.71')  
 Nail & K.C. remon tag in W side 12" Maple Due South 21.68' (m. 21.95')

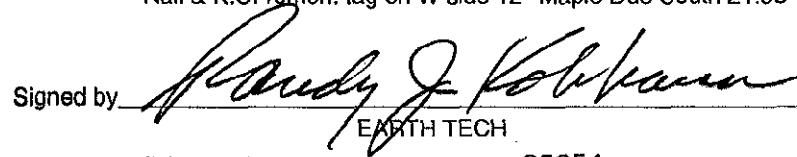
The selected location is accepted by me and is generally accepted by professional surveyors as the best available evidence of the position of the original corner.

## C. Description of monument for corner and accessories established to perpetuate locating the position of the corner:

E-3 Standard Kent County Witness Monument

Nail & K.C. remon. tag on N side 12" Ash N 85° W 10.62'  
 Nail & K.C. remon. tag on N side 14" Ash N 50° W 15.97'  
 Nail & K.C. remon. tag on E side 12" Twin Maple N 15° W 23.08'  
 Nail & K.C. remon. tag on W side 18" Oak N 15° E 14.44'  
 Nail & K.C. remon. tag on S side 6" Maple N 80° E 4.71'  
 Nail & K.C. remon. tag on W side 12" Maple Due South 21.95'

Signed by

  
 EARTH TECH

Date

9-1-98

Surveyor's Michigan License No. 25854