

\$7.00
\$2.00

MAR 06 1999

other code #7
Seq # 2

SECTION

LAND CORNER RECORDATION CERTIFICATE
Filing Requirement of Act 74, Mich. P.A. 1970
KENT COUNTY REMONUMENTATION

REG. OF DEEDS

Lucy Hand

98 OCT 23 AM 9:58

STATE OF MICHIGAN
COUNTY OF KENT
RECEIVED FOR RECORD

10852

Register of Deeds Stamp & File Number

For corners in

Kent
(County)

Located in: Grattan
Township

Corner Code #

1. Public Land Survey
T 8N R 9W E-3N
T R
T R Witness Monument
T R
2. Property Controlling
in Section S T R
S T R
3. Miscellaneous
Property in Sec. S T R
S T R
4. Lot No. , Recorded Plat
5. Private Claims

I, Randy Kolehouse, in a field survey on March 24 19 98, do hereby certify that under requirements of P.A. 74 Michigan P.A. of 1970, the corner points mentioned in lines 1 and 2 above were in conformance with regulations and rules therefore as required in the current manual of survey instructions of the United States Department of the interior, Bureau of Land Management or by a decree of a Court of Law and/or that the corner points mentioned in lines 3, 4 and 5 above were in conformance with the rules of the Michigan Board of Land Surveyors or by a Decree of a Court of Law; established, re-established, monumented, re-monumented, recovered, found as expressed below:

NOTE: Not more than 4 corners, all in the same town and range, may be recorded on this certificate.

A. Description of original monument and accessories and/or subsequent restoration:

E-3	1837	G.L.O. Notes	Cathcart	Meander Corner
	1993	L.C.R.C. #6777	Thomas Starr	Set K.C. Witness Monument
	1995	L.C.R.C. #8011	Glaza & Associates	K.C. Witness Monument

P.A. 345 1990 KENT COUNTY

PEER APPROVED 6/25/98

CHAIRMAN *Stan Thibodeau*

This corner was originally approved by the Kent County Remonumentation Peer Group and monumented by Thomas Starr on 3/15/98 and was recorded per L.C.R.C. #6777.

B. Description of corner evidence found and/or method applied in restoring or reestablishing corner:

E-3 Found a Standard Kent County Witness Monument on the North side of Muskrat Lake 5.1' East of a fence line running North and South and 50' ± North of the North edge of swamp per L.C.R.C.'s #6777 and #8011 as set by Thomas Starr 1880' South of E-2.

L.C.R.C. #6777

Nail & Tag in E. side 4" Oak Due North 3.44'
Nail & Tag in E. side 36" Oak N 25° E 25.10'
Nail & Tag in S. side 8" Thornapple S 80° E 7.48'
Nail & Tag in E. side 4" Oak S 20° W 8.75'

L.C.R.C. #8011


Nail & K.C. remon tag in E side 5" Oak Due North 3.44' (m. 3.50')
Nail & K.C. remon tag in E side 36" Oak N 25° E 25.10' (m. 25.20')
Nail & K.C. remon tag in S side 8" Thornapple S 80° E 7.50' (m. 7.54')
Nail & K.C. remon tag in E side 4" Oak S 20° W 8.76' (m. 8.77')
North and South fence line West 5.1'
19.5' North to iron (All-Points capped re-rod)

The selected location is accepted by me and is generally accepted by professional surveyors as the best available evidence of the position of the original corner.

C. Description of monument for corner and accessories established to perpetuate locating the position of the corner:

E-3 Standard Kent County Witness Monument

Nail & K.C. remon. tag on E side 5" Oak N 00° E 3.50'
Nail & K.C. remon. tag on E side 36" Oak N 25° E 25.20'
Nail & K.C. remon. tag on S side 8" Thornapple S 80° E 7.54'
Nail & K.C. remon. tag on E side 4" Oak S 20° W 8.77'
All-Points capped re-rod North 19.5'
Fence line running N-S, West 5.1'

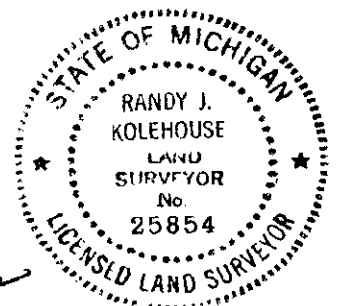

Signed by *Randy J. Kolehouse*

Date 9-1-98

Surveyor's Michigan License No. 25854