

**SURVEY &
REMONUMENTATION**

MAY 22 2000

SECTION

**LAND CORNER RECORDATION CERTIFICATE
Filing Requirement of Act 74, Mich. P.A. 1970**

KENT COUNTY REMONUMENTATION

For corners in

Kent
(County)

Located in: Courtland
Township

Corner Code #

1. Public Land Survey T 9N R 10W G-10S
T _____ R _____
T _____ R _____
T _____ R _____
2. Property Controlling S T R 629.65 South
in Section S T R Of G-10
3. Miscellaneous S T R
Property in Sec. S T R
4. Lot No. _____, Recorded Plat _____
5. Private Claims _____

*Deg. 2
"Other code #3*
REG. OF DEEDS
1999 OCT 15 AM 8:05
11324

STATE OF MICHIGAN
COUNTY OF KENT
RECEIVED FOR RECORD


Register of Deeds Stamp & File Number

I, Randy Kolehouse, in a field survey on January 28 19 99, do hereby certify that under requirements of P.A. 74 Michigan P.A. of 1970, the corner points mentioned in lines 1 and 2 above were in conformance with regulations and rules therefore as required in the current manual of survey instructions of the United States Department of the Interior, Bureau of Land Management or by a decree of a Court of Law and/or that the corner points mentioned in lines 3, 4 and 5 above were in conformance with the rules of the Michigan Board of Land Surveyors or by a Decree of a Court of Law; established, re-established, monumented, re-monumented, recovered, found as expressed below:

NOTE: Not more than 4 corners, all in the same town and range, may be recorded on this certificate.

A. Description of original monument and accessories and/or subsequent restoration:

G-10 1837 G.L.O. Notes Cathcart Set Post
N/A Peninsula Park Plat L. 27 P. 5 NA Iron Pipe
1994 L.C.R.C. #6964 William R. Byl Fnd. 1" Iron Pipe / Set K.C. Witness Monument

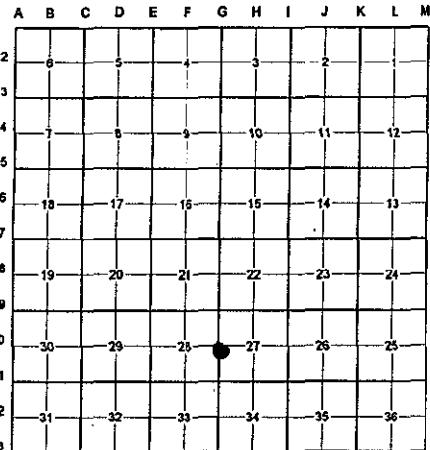

B. Description of corner evidence found and/or method applied in restoring or reestablishing corner:

G-10 Found a Standard Kent County Witness Monument 15' + South of the C/L of Peninsula Drive (bit.) running East and West per L.C.R.C. #6964 as set by William Byl in place of a 1" iron pipe he found at the NW corner of Lot 59 of Peninsula Park (Liber 27, Page 5).

L.C.R.C. #6964

SE cor. fndn. Hse. #7191 (extension of hse.) N55°W 76.41' (m. 76.42'
SW cor. fndn. Hse. #7199 N 10°E 62.26' (m. 62.28')
SE cor. fndn. Garage N65°E 96.77' (m. 96.75')
Nail & KC Remon. tag N. side Power Pole S85°E 82.91' (m. 82.96')
NNWly face of Power Pole S20°E 0.75'
C/L Manhole N15°W 14.18'

P.A. 345 1990 KENT COUNTY

PEER APPROVED 2/25/99

CHAIRMAN Randy J. Kolehouse

The selected location is accepted by me and is generally accepted by professional surveyors as the best available evidence of the position of the original corner.

C. Description of monument for corner and accessories established to perpetuate locating the position of the corner:

G-10 Standard Kent County Witness Monument

SE cor. hse. fndn. #7191 (extension of hse.) :N 55° W 76.42'
SW cor. hse. fndn. #7199 N 10° E 62.28'
SE cor. gar. fndn. N 65° E 96.75'
Nail & K.C. remon. tag on N side P. pole S 85° E 82.96'
NNWly face P. pole S 20° E 0.75'
C/L manhole N 15° W 14.18'
C/L of bit. road running E-W, North 15' +

Signed by

Randy J. Kolehouse
WILLIAMS & WORKS

Surveyor's Michigan License No. 25854

Date

