

SURVEY &
REMONUMENTATION

\$7.00
\$2.00

MAY 22 2000

KENT COUNTY REMONUMENTATION

SECTION

LAND CORNER RECORDATION CERTIFICATE
Filing Requirement of Act 74, Mich. P.A. 1970

For corners in

KENT COUNTY

(County)

Located In:

Corner Code #

1. Public Land Survey

T R
T R
T R
T R

2. Property Controlling
in Section

S 4 T 10N R 11W

Wit. Mon. on

3. Miscellaneous
Property in Sec.

S T R
S T R

N. Sec. (Twp.) Line

Solon Twp.

4. Lot No. , Recorded Plat

5. Private Claims

Kirk Breitels

June 10, 1999

I, in a field survey on do hereby state that under requirements of P.A. 74, Michigan P.A. of 1970, the corner points mentioned in lines 1 and 2 above were in conformance with regulations and rules therefore as required in the current manual of survey instructions of the United States Department of the Interior, Bureau of Land Management or by a decree of a Court of Law and /or that the corner points mentioned in lines 3, 4 and 5 above were in conformance with the rules of the Michigan Board of Land Surveyors or by a Decree of a Court of Law, established, re-established, monumented, recovered, found as expressed below:

NOTE: Not more than 2 corners, all in the same town and range, may be recorded on this certificate.

A. Description of original monument and accessories and/or subsequent restoration:

1837 GLO Cathcart Not Set

1993 LCRC #6802 W. Glaza

Set Kent Co. Witness Monument on Sec. (Twp.) Line at waters edge of Gilbert Lake.

The position of this corner was previously approved by the Kent County Remonumentation Peer Group, as monumented by Wallace E. Glaza on 8-9-93 and was recorded per LCRC #6802

B. Description of corner evidence found and/or method applied in restoring or reestablishing corner:

Found Kent Co. Witness Monument per witnesses of above LCRC as set by Wallace C. Glaza.

Nail & KC Remon. tag E. side 30" Oak N18°W 21.71'

Nail & KC Remon. tag S. side 42" Oak N73°E 41.17'

Nail & KC Remon. tag E. side 12" Maple S19°E 38.92'

Nail & KC Remon. tag N. side 10" Maple S66°W 26.85'

SE corner house #7086 N55°W 63.00'

P.A. 345 1990 KENT COUNTY

PEER APPROVED

CHAIRMAN

The above location is accepted by me and is generally accepted by professional surveyors as the best available evidence of the position of the Witness Corner.

C. Description of monument for corner and accessories established to perpetuate locating the position of the corner:

Kent County Witness Monument


Nail & KC Remon. tag E. side 32" Oak N18°W 21.80'

Nail & KC Remon. tag S. side 42" Oak N73°E 41.17'

Nail & KC Remon. tag E. side 14" Maple S19°E 38.92'

Nail & KC Remon. tag N. side 12" Maple S66°W 26.88'

SE corner house #7086 N55°W 63.08'

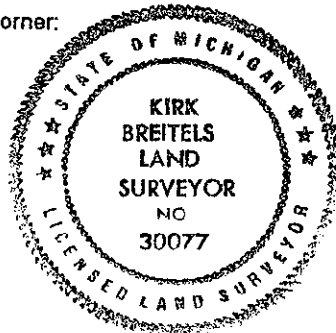

Signed by

Surveyor's Michigan License No.

30077

Date

6/24/99