

LAND SURVEY &
REMONUMENTATION

MAY 22 2000

KENT COUNTY REMONUMENTATION

SECTION

LAND CORNER RECORDATION CERTIFICATE
Filing Requirement of Act 74, Mich. P.A. 1970

For corners in

KENT COUNTY
(County)


Located In: Corner Code #

1. Public Land Survey	T <u> </u> R <u> </u>	<u> </u>
	T <u> </u> R <u> </u>	<u> </u>
	T <u> </u> R <u> </u>	<u> </u>
	T <u> </u> R <u> </u>	<u> </u>
2. Property Controlling in Section	S <u> </u> T <u>10N R 11W</u>	Wit. Mon. on N-S 1/4 Line
	S <u> </u> T <u> </u> R <u> </u>	
3. Miscellaneous Property in Sec.	S <u> </u> T <u> </u> R <u> </u>	


4. Lot No. , Recorded Plat
5. Private Claims

I, Kirk Breitels, in a field survey on June 1, 1999 do hereby state that under requirements of P.A. 74, Michigan P.A. of 1970, the corner points mentioned in lines 1 and 2 above were in conformance with regulations and rules therefore as required in the current manual of survey instructions of the United States Department of the Interior, Bureau of Land Management or by a decree of a Court of Law and/or that the corner points mentioned in lines 3, 4 and 5 above were in conformance with the rules of the Michigan Board of Land Surveyors or by a Decree of a Court of Law; established, re-established, monumented, recovered, found as expressed below:

NOTE: Not more than 2 corners, all in the same town and range, may be recorded on this certificate.

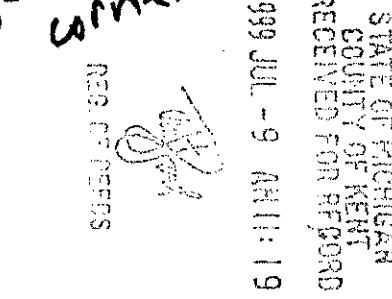

11237
Register of Deeds Stamp & File Number

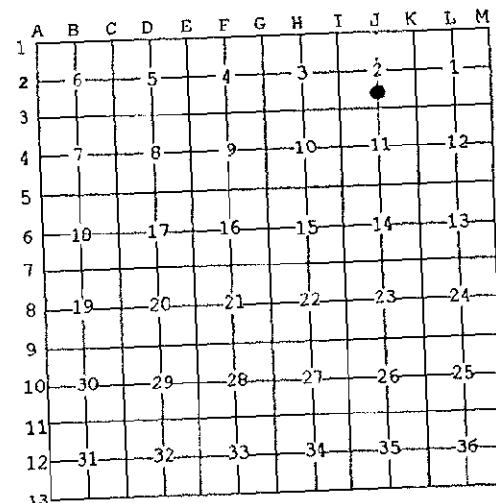

A. Description of original monument and accessories and/or subsequent restoration:

1837 GLO Cathcart
1993 LCRC #6807 W. Glaza
Not Set
Set Kent Co. Witness Monument on N-S 1/4 Line 1479.20' South of the
Central 1/4 corner of Sec. 2

The position of this corner was previously approved by the Kent County Remonumentation Peer Group, as
monumented by Wallace E. Glaza on 8-17-93 and was recorded per LCRC #6807

B. Description of corner evidence found and/or method applied in restoring or reestablishing corner:

Found Kent Co. Witness Monument per witnesses of above LCRC as set by Wallace E. Glaza.

Nail & KC Remon. tag NW side 10" Poplar	N38°E 9.18'
Nail & KC Remon. tag E. side 18" Elm	S08°E 30.72'
Nail & KC Remon. tag SE side clump Maple	S48°W 47.58'
Nail & KC Remon. tag S. side 10" Poplar	S75°W 12.68'
Nail & KC Remon. tag W. side 10" Poplar	S27°W 9.90'

P.A. 345 1990 KENT COUNTY

PEER APPROVED 6/24/99

CHAIRMAN

South edge of field is North 20' ±
The above location is accepted by me and is generally accepted by professional surveyors as the best available evidence
of the position of the Witness Corner.

C. Description of monument for corner and accessories established to perpetuate locating the position of the corner:

Kent County Witness Monument
Nail & KC Remon. tag NW side 10" stump
Nail & KC Remon. tag E. side 20" Elm
Nail & KC Remon. tag SE side clump Maple
Nail & KC Remon. tag S. side 12" Poplar
Nail & KC Remon. tag W. side 14" Poplar
N38°E 9.14'
S08°E 30.70'
S48°W 47.58'
S75°W 12.64'
S27°W 9.93'
South edge of field is North 20' ±



Signed by Kirk Breitels
Surveyor's Michigan License No. 30077

Date 6/24/99