

**SURVEY &
REMONUMENTATION**

MAY 22 2000

SECTION

KENT COUNTY REMONUMENTATION

~~\$1.00
\$2.00~~

**LAND CORNER RECORDATION CERTIFICATE
Filing Requirement of Act 74, Mich. P.A. 1970**

For corners in

KENT COUNTY
(County)

Located In: Corner Code #

| | | |
|---------------------------------------|---------------------------------------|------------------------------|
| 1. Public Land Survey | T <u> </u> R <u> </u> | <u> </u> |
| | T <u> </u> R <u> </u> | <u> </u> |
| | T <u> </u> R <u> </u> | <u> </u> |
| | T <u> </u> R <u> </u> | <u> </u> |
| 2. Property Controlling in Section | S <u> </u> T <u>10N</u> R <u>11W</u> | Wit. Mon. on S. Sec. Line |
| 3. Miscellaneous Property in Sec. | S <u> </u> T <u> </u> R <u> </u> | <u> </u> |
| | S <u> </u> T <u> </u> R <u> </u> | <u> </u> |

4. Lot No. , Recorded Plat
5. Private Claims

I, Kirk Breitels, in a field survey on June 1, 1999 do hereby state that under requirements of P.A. 74, Michigan P.A. of 1970, the corner points mentioned in lines 1 and 2 above were in conformance with regulations and rules therefore as required in the current manual of survey instructions of the United States Department of the Interior, Bureau of Land Management or by a decree of a Court of Law and/or that the corner points mentioned in lines 3, 4 and 5 above were in conformance with the rules of the Michigan Board of Land Surveyors or by a Decree of a Court of Law; established, re-established, monumented, recovered, found as expressed below:


NOTE: Not more than 2 corners, all in the same town and range, may be recorded on this certificate.

RECEIVED
REG. DEPT.
STATE OF MICHIGAN
COUNTY OF KENT
RECEIVED FOR RECORD

1993 JUL - 6 AM 11:19
613485

11235

Register of Deeds Stamp & File Number

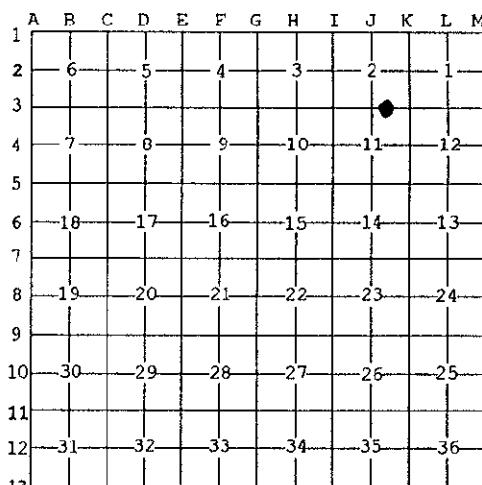

A. Description of original monument and accessories and/or subsequent restoration:

| | | | |
|------|------------|----------|---|
| 1837 | GLO | Cathcart | Not Set |
| 1993 | LCRC #6809 | W. Glaza | Set Kent Co. Witness Monument on Sec. Line 2026.10' West of SE corner of Sec. 2 |

The position of this corner was previously approved by the Kent County Remonumentation Peer Group, as monumented by Wallace E. Glaza on 8-17-93 and was recorded per LCRC #6809

B. Description of corner evidence found and/or method applied in restoring or reestablishing corner:

Found Kent Co. Witness Monument per witnesses of above LCRC as set by Wallace E. Glaza.

Nail & KC Remon. tag NW side 8" Oak S65°W 13.99'
Nail & KC Remon. tag SW side 14" Oak N38°W 10.79'
Nail & KC Remon. tag SE side 24" Maple N38°E 49.52'
Nail & KC Remon. tag N. side 24" Maple N79°E 51.03'
Nail & KC Remon. tag W. side 36" Oak S25°E 52.62'
Centerline of 2 track is South 160' ±

P.A. 345 1990 KENT COUNTY

PEER APPROVED 6/24/99

CHAIRMAN James J. Glaza

The above location is accepted by me and is generally accepted by professional surveyors as the best available evidence of the position of the Witness Corner.

C. Description of monument for corner and accessories established to perpetuate locating the position of the corner:

Kent County Witness Monument

Nail & KC Remon. tag NW side 10" Oak S65°W 14.02'
Nail & KC Remon. tag SW side 16" Oak N38°W 10.77'
Nail & KC Remon. tag SE side 26" Maple N38°E 49.52'
Nail & KC Remon. tag N. side 26" Maple N79°E 51.03'
Nail & KC Remon. tag W. side 40" Oak S25°E 52.71'
East-West fence is 6' South



Signed by Kirk Breitels

Date 6/24/99

Surveyor's Michigan License No. 30077