

**SURVEY & REMONUMENTATION**

NOV 15 1993

**LAKE COUNTY REMONUMENTATION**

**COMMISSION**

**LAND CORNER RECORDATION CERTIFICATE**

**LIBER 003 PAGE 0178**

**Filing Requirement of Act 74, Mich. P.A. 1970**

For corners in Lake \_\_\_\_\_

For corners in Lake _____ (County)	Located In:	Corner Code -#
1. Public Land Survey	T 17N R 14W	B-13
	T _____ R _____	_____
	T _____ R _____	_____
	T _____ R _____	_____
2. Property Controlling in Section	S _____ T _____ R _____	_____
	S _____ T _____ R _____	_____
3. Miscellaneous Property in Sec.	S _____ T _____ R _____	_____
	S _____ T _____ R _____	_____

REGISTER OF DEEDS  
 Nov 9 3 40 PM '93  
 RECORDED  
 LAKE COUNTY, MI.

Register of Deeds Stamp & File Number

4. Lot No. \_\_\_\_\_, Recorded Plat \_\_\_\_\_  
 5. Private Claims \_\_\_\_\_

	A	B	C	D	E	F	G	H	I	J	K	L	M
2	6	5	4	3	2	1							
3													
4	7	8	9	10	11	12							
5													
6	18	17	16	15	14	13							
7													
8	19	20	21	22	23	24							
9													
10	30	29	28	27	26	25							
11													
12	31	32	33	34	35	36							
13													

I, Robert L. Wetherell, in a field survey on October 26, 1993, do hereby certify that under requirements of P.A. 74, Michigan P.A. of 1970, the corner points mentioned in lines 1 and 2 above were in conformance with regulations and rules therefore as required in the current manual of survey instructions of the United States Department of the Interior, Bureau of Land Management or by a decree of a Court of Law and/or that the corner points mentioned in lines 3, 4 and 5 above were in conformance with the rules of the Michigan Board of Land Surveyors or by a Decree of a Court of Law; established, re-established, monumented, re-monumented, recovered, found as expressed below:

**NOTE: Not more than 4 corners, all in the same town and range, may be recorded on this certificate.**

**A. Description of original monument and accessories and/or subsequent restoration:**

B-13 (1/4 cor. Sec 31 on the county line, T17N, R14W)

GLO Resurvey 1856 by Thomas Whelpley

#1 30" W. Pine N01°E 79 Links

#2 8" W. Oak S20 1/2°W 28 Links

Undated Survey by County Surveyor G. H. Johnson (Iron Pipe)

#3 8" B. Oak N16°E 35.5'

1967 by R. A. Griffin L.S. 13584

#4 10" R. Pine N66°E 71.90'

#5 2" W. Pine N07°E 36.05'

#6 8" W. Oak S47°E 78.75'

#7 2" W. Pine S02°E 32.90'

**B. Description of corner evidence found and/or method applied in restoring or reestablishing corner:**

B-13 (1/4 cor. Sec. 31 on the county line, T17N, R14W)

R. A. Griffin in 1967 found 3/4" x 24" Iron Pipe and Surveyor Johnson's witness #3. Griffin replaced Iron Pipe with 5" sq. x 36" Concrete Monument with brass cap.

I found Griffin's concrete monument in good condition. Condition of recorded witnesses is: #1 Gone; #2 Gone; #3 Gone; #4 Gone; #5 Gone; #6 Found in good condition; #7 Gone.

**C. Description of monument for corner and accessories established to perpetuate locating the position of the corner:**

B-13 (1/4 cor. Sec. 31 on the county line, T17N, R14W)

Accepted R. A. Griffins Concrete Monument with brass cap as a substantial marker for the 1/4 corner, and is accepted as a careful and faithful re-establishment of the position of the original corner.

11" W. Oak S47°E 78.75' (10" dock spike in N.E. side of tree) (#6)

12" W. Oak S32°W 72.40' (10" dock spike in N.W. side of tree)


10" W. Oak N10°E 62.13' (60d. nail in East side of tree)

8" W. Oak N23°W 61.63' (60d. nail in N.E. side of tree)

Signed by Robert L. Wetherell

Date 11-5-93

Surveyor's Michigan License No. L.S. 24624

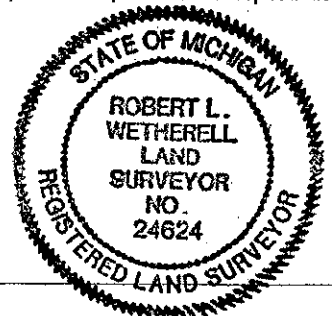

Approved by Peer Review Group October 27, 1993

Robert L. Wetherell, County Representative

*RLW.*