

SURVEY & REMONUMENTATION

JAN 14 1998

SECTION

LAND CORNER RECORDATION CERTIFICATE
Filing Requirement of Act 74, Mich. P.A. 1970

For corners in Lake


(County)	Located In:	Corner Code ##
1. Public Land Survey	T 20N R 13W	E-5
	T _____ R _____	_____
	T _____ R _____	_____
	T _____ R _____	_____
2. Property Controlling in Section	S _____ T _____ R _____	_____
	S _____ T _____ R _____	_____
3. Miscellaneous Property in Sec.	S _____ T _____ R _____	_____
	S _____ T _____ R _____	_____

RECORDED
LAKE COUNTY, MI.
LIBER 004 PAGE 0104
Dec 12 11 39 AM '97

Rebecca H. Dickson
REGISTER OF DEEDS

Register of Deeds Stamp & File Number

4. Lot No. _____, Recorded Plat _____
 5. Private Claims _____

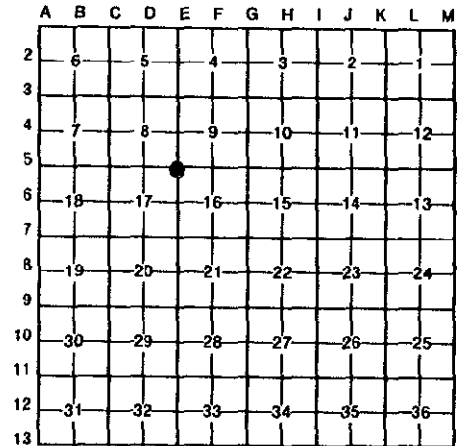

I, Robert L. Wetherell, in a field survey on September 22, 1997, do hereby certify that under requirements of P.A. 74, Michigan P.A. of 1970, the corner points mentioned in lines 1 and 2 above were in conformance with regulations and rules therefore as required in the current manual of survey instructions of the United States Department of the Interior, Bureau of Land Management or by a decree of a Court of Law and/or that the corner points mentioned in lines 3, 4 and 5 above were in conformance with the rules of the Michigan Board of Land Surveyors or by a Decree of a Court of Law; established, re-established, monumented, re-monumented, recovered, found as expressed below:

NOTE: Not more than 4 corners, all in the same town and range, may be recorded on this certificate.

A. Description of original monument and accessories and/or subsequent restoration:
E-5 - Section corner common to Sections 8, 9, 16 & 17, T20N, R13W, Lake Co., Mi.

- | | |
|------------------------------------|--|
| <u>1839 - J. Brink, G.L.O.</u> | <u>1917 - George Johnson, Co. Sur.</u> |
| #1 - 10" W. Pine N74°W 6 Links | 20" Angle Iron |
| #2 - 12" Pitch Pine S15°E 28 Links | #3 - 6" W. Oak S58°E 110' |

- 1978 - Robert Griffin, LS 13584
 L.C.R.C. - Liber 03, Page 009.
 Found railroad splice plate
 Replaced (in 1985) with a 5" x 36" Concrete Monument.
 #4 - 8" R. Pine S86°W 64.34'
 #5 - 5" Maple S47°W 76.34'
 #6 - 8" W. Oak S42°E 13.54'
 #7 - 4" Pine Post West 2.10'

B. Description of corner evidence found and/or method applied in restoring or reestablishing corner:

E-5 - Section corner common to Sections 8, 9, 16 & 17, T20N, R13W, Lake Co., Mi.

I found the 5" Concrete Monument by Griffin, 13 feet East of a North and South dirt road.

Condition of the accessories are as follows: #1 Gone, #2 Gone, #3 Found Stump, #4 Found in good condition, #5 Found a dead Black Oak with U.S.F.S. Tag, #6 Found in good condition, #7 Found 1.2' West.

RATIFIED BY THE LAKE CO. PEER REVIEW GROUP
 IN ACCORDANCE WITH P.A. 345
 CHAIRMAN R.H.W.
 DATE 12-10-97

C. Description of monument for corner and accessories established to perpetuate locating the position of the corner:

E-5 - Section corner common to Sections 8, 9, 16 & 17, T20N, R13W, Lake Co., Mi.

I accepted the 5" Square Concrete Monument as a substantial marker for the corner, and is accepted as a careful and faithful re-establishment of the position of the original corner.

- 13" R. Pine S88°W 64.30' (dock spike in S. side) #4
- 11" W. Oak S35°E 13.58' (dock spike in N. side) #6
- 4" W. Pine S18°E 90.74' (60d spike in W. side)
- 5" W. Pine S72°E 89.74' (60d spike in N. side)

Signed by Robert L. Wetherell
 Surveyor's Michigan License No. 24624

Date 12-12-97

