

MAR 17 2000

FILED

SECTION

LAND CORNER RECORDATION CERTIFICATE  
Filing Requirement of Act 74, Mich. P.A. 1970

1999 NOV 22 A 11:09

NANCY HAVILAND  
REGISTER OF DEEDS  
LIVINGSTON COUNTY, MI.  
48843

For corners in  
LIVINGSTON  
(County)

Located in: HAMBURG Corner Code #

9

- 1. Public Land Survey T 1N R 5E G-5  
T R  
T R  
T R
- 2. Property Controlling S T R  
in Section S T R
- 3. Miscellaneous S T R  
Property in Sec. S T R

J.S.C# 1119m

Register of Deeds Stamp and File Number

- 4. Lot No. \_\_\_\_\_, Recorded Plat \_\_\_\_\_
- 5. Private Claims \_\_\_\_\_

A	B	C	D	E	F	G	H	I	J	K	L	M
2	6	5	4	3	2	1						
3												
4	7	8	9	10	11	12						
5												
6	18	17	16	15	14	13						
7												
8	19	20	21	22	23	24						
9												
10	30	29	28	27	26	25						
11												
12	31	32	33	34	35	36						
13												

I, Bryan L. Boss, In a field survey on 10-12-99

do hereby certify that under requirements of P.A. 74, Michigan P.A. of 1970, the corner points mentioned in lines 1 and 2 above were in conformance with regulations and rules therefor as required in the current manual of survey instructions of the United States Department of the Interior, Bureau of Land Management or by a decree of a Court of Law and/or that the corner points mentioned in lines 3, 4 and 5 above were in conformance with the rules of the Michigan Board of Land Surveyors or by a Decree of a Court of Law; established, re-established, monumented, re-monumented, recovered, found as expressed below.

NOTE: Not more than 4 corners, all in the same town and range, may be recorded on this certificate.

A. Description of original monument and accessories and/or subsequent restoration:


SET POST  
WHITE OAK 26" N59°E 49L  
WHITE OAK 24" S79°W 1.33 CH

B. Description of corner evidence found and/or method applied in restoring or reestablishing corner:

FOUND 1 1/2" IRON PIPE IN NORTH-SOUTH OCCUPATION LINE

C. Description of monument for corner and accessories established to perpetuate locating the position of the corner:

SET 1 1/4" X 3/8" PIPE WITH BRASS CAP STAMPED  
" LIVINGSTON COUNTY REMONUMENTATION  
CORNER"  
SOUTH 103.00' FOUND MATT BRADY IRON  
S05°E 36.91' SET REMON NAIL & TAG W/S 14"  
WALNUT  
N10°E 73.67' SET REMON NAIL & TAG E/S 14" ELM  
S70°W 108.09' SET REMON NAIL & TAG S/S 10"  
ELM  
V. 119.24' SOUTHEAST CORNER HOUSE  
N 37.89' SET REMON NAIL & TAG S/S 6" ELM

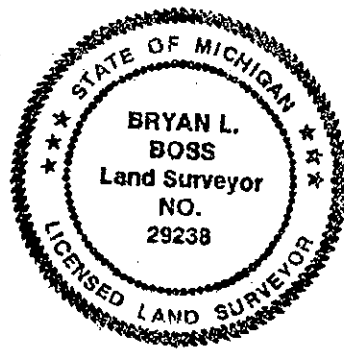

PA. 345 1990, APPROVED BY LIVINGSTON COUNTY  
PEER GROUP ON 8.4.99 CO. REP JED

Signed by [Signature]

Date NOV. 9 1999

Surveyor's Michigan License No. 29238