

FEB 25 1999

SECTION

LAND CORNER RECORDATION CERTIFICATE
Filing Requirement of Act 74, Mich. P.A. 1970

FILED

For corners in

LIVINGSTON
(County)

Located In:

Corner Code #

- 1. Public Land Survey T4N R 3E H9
- T R
- T R
- T R
- 2. Property Controlling S T R
- in Section S T R
- 3. Miscellaneous S T R
- Property in Sec. S T R

91

1998 AUG 20 P 4: 45

NANCY HAVILAND
REGISTER OF DEEDS
LIVINGSTON COUNTY, MI.
48843

L.S.C. #885m

Register of Deeds Stamp & File Number

- 4. Lot No. _____, Recorded Plat _____
- 5. Private Claims _____


CHARLES E GARLOCK, in a field survey on JULY 8, 1998 do hereby state that under requirements of P.A. 74, Michigan P.A. of 1970, the corner points mentioned in lines 1 and 2 above were in conformance with regulations and rules therefore as required in the current manual of survey instructions of the United States Department of the Interior, Bureau of Land Management or by a decree of a Court of Law and/or that the corner points mentioned in lines 3, 4 and 5 above were in conformance with the rules of the Michigan Board of Land Surveyors or by a Decree of a Court of Law; established, re-established, monumented, recovered, found as expressed below:

NOTE: Not more than 2 corners, all in the same town and range, may be recorded on this certificate.

| | | | | | | | | | | | | | |
|----|---|----|---|----|---|----|---|----|---|----|---|----|---|
| 1 | A | B | C | D | E | F | G | H | I | J | K | L | M |
| 2 | | 6 | | 5 | | 4 | | 3 | | 2 | | 1 | |
| 3 | | | | | | | | | | | | | |
| 4 | | 7 | | 8 | | 9 | | 10 | | 11 | | 12 | |
| 5 | | | | | | | | | | | | | |
| 6 | | 18 | | 17 | | 16 | | 15 | | 14 | | 13 | |
| 7 | | | | | | | | | | | | | |
| 8 | | 19 | | 20 | | 21 | | 22 | | 23 | | 24 | |
| 9 | | | | | | | | 27 | | 26 | | 25 | |
| 10 | | 30 | | 29 | | 28 | | 27 | | 26 | | 25 | |
| 11 | | | | | | | | | | | | | |
| 12 | | 31 | | 32 | | 33 | | 34 | | 35 | | 36 | |
| 13 | | | | | | | | | | | | | |

A. Description of original monument and accessories and/or subsequent restoration:

GLO SURVEY DATED: APRIL 15, 1825 BY S SIBLEY, DS
GLO WITNESSES: MAPLE 12-N60E-3 LKS
BEECH 20-S81½W-32 LKS

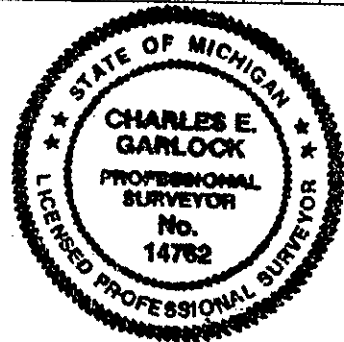

ADDITIONAL DATA ON REAR OF SHEET

B. Description of corner evidence found and/or method applied in restoring or reestablishing corner:

FOUND 1/2" I. ROD 2 FT. SOUTH OF ROAD CENTERLINE AND OCCUPATION N AND S.

C. Description of monument for corner and accessories established to perpetuate locating the position of the corner:

H9: N¼ COR. SEC. 27, T4N-R3E; CONWAY TWP. LIV. CO. MI, RESET ½" I. ROD WITH 1 ¼" X 36" BREAKAWAY I. PIPE AT -0.5' WITH LIV. CO. REMON BRASS CAP ON TOP.
S70W-41.01'-SP & TAG W/S 14" WALNUT
N68W-83.29'-SP & TAG W/S 20" ASH
N54E-32.93'-SP & TAG W/S 20" HICKORY
S67E-73.58'-SP & TAG W/S 18" WALNUT

Signed by Charles E. Garlock
Surveyor's Michigan License No. 14762

Date JULY 20, 1998

P.A. 345 1990, APPROVED BY LIVINGSTON COUNTY
PEER GROUP ON 2/11/98, CO. REP JED