

LAND CORNER RECONSTRUCTION CERTIFICATE
Filing Requirement of Act 74, Mich. P.A. 1970

For corners in

MANISTEE

(County)

Located In:

Corner Code = #

T23N 14W H-13

H-1, H-2

H-01

REGISTER'S OFFICE
MANISTEE COUNTY

#93-509 AT 4:00 p.m.

OCT 5 1993

Penney A. Pomeroy
REGISTER OF DEEDS

Register of Deeds Stamp & File Number

1. Public Land Survey

T 22N R 14W

T 22N R 14W

T 22N R 14W

T 22N R 14W

2. Property Controlling
in Section

S T R

S T R

3. Miscellaneous
Property in Sec.

S T R

S T R

4. Lot No. , Recorded Plat

5. Private Claims

I, Norman C. Caldwell, in a field survey on October, 1991, do hereby certify that under requirements of P.A. 74, Michigan P.A. of 1970, the corner points mentioned in lines 1 and 2 above were in conformance with regulations and rules therefore as required in the current manual of survey instructions of the United States Department of the Interior, Bureau of Land Management or by a decree of a Court of Law and/or that the corner points mentioned in lines 3, 4 and 5 above were in conformance with the rules of the Michigan Board of Land Surveyors or by a Decree of a Court of Law; established, re-established, monumented, re-monumented, recovered, found as expressed below:

NOTE: Not more than 4 corners, all in the same town and range, may be recorded on this certificate.

	A	B	C	D	E	F	G	H	I	J	K	L	M
2	6	5	4	3	2	1							
3													
4	7	8	9	10	11	12							
5													
6	18	17	16	15	14	13							
7													
8	19	20	21	22	23	24							
9													
10	30	29	28	27	26	25							
11													
12	31	32	33	34	35	36							
13													

A. Description of original monument and accessories and/or subsequent restoration:

H-1 1/4 cor., Sec. 3, 22/14W & 34, 23/14W

H-2 C 1/4, Sec. 3

Post placed by John Brink in 1839 Township line survey.
N46°E 56 lks. (36.96') 13" Beech
N44°W 58 lks. (38.28') 11" Hemlock

This position not established by original government survey.


B. Description of corner evidence found and/or method applied in restoring or reestablishing corner:

H-1 1/4 cor., Sec. 3, 22/14W & 34, 23/14W

H-2 C 1/4, Sec. 3

Found 1" iron pipe alongside large rock by A. Slawinski, #13597.
N40°E 41.83' 12" Red Oak
N80°E 51.97' 16" Twin Beech
S10°W 40.54' 30" Maple

No Prior Record

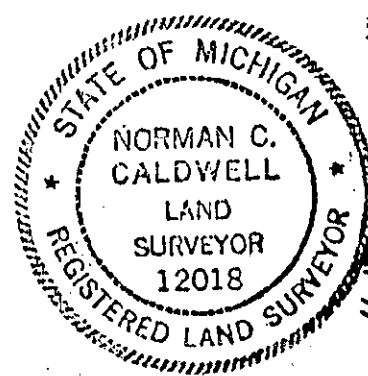

ratified by the Manistee County Peer Group pursuant to P.A. 123 of 1915, as amended by P.A. 345 of 1990, as amended. Date of Peer Review: APRIL 5, 1993 (H-13, MAPLE GROVE)

C. Description of monument for corner and accessories established to perpetuate locating the position of the corner:

H-2 C 1/4, Sec. 3, T22N-R14W

H-1

1/4 cor., Sec. 3, R22N-R14W & Sec. 34, T23N-R14W

Placed 5" x 36" conc. monument w/brass cap #16923, 1991. This position not established by original government survey. This monument is accepted as a careful and faithful determination of the position of the corner.
N74°W 3.97' 9" Beech
N85°E 20.25' 4" Maple S.
S01°W 22.69' 6" Maple S.
North 1.0' Carsonite Witness Post

Found 1" pipe near large stone and replaced with 5" x 30" conc. monument and is accepted as the best available evidence of the position of the original corner.
N40°E 41.83' 14" Oak B.
N80°E 51.97' 18" Twin Beech
S10°W 40.54' 30" Maple
N70°W 23.87' 8" Poplar
West 150'± CL gravel road to West
South 20'± CL 2 track E-W
North 180'± CL gravel road to North
Carsonite Witness Post alongside

Signed by

Date

7 JAN. 1992

Surveyor's Michigan License No.

12018

FORM APPROVED BY MICHIGAN STATE BOARD OF LAND SURVEYORS, JAN. 28, 1971
REVISED MAY 14, 1975
REVISED JAN., 1983

23 AUG. 1993