

DEC 07 1999

LAND CORNER RECORDATION CERTIFICATE
Filing Requirement of Act 74, Mich. P.A. 1970

For corners in Manistee County (County)

Located In:

Corner Code #

SECTION

REGISTER'S OFFICE
MANISTEE COUNTY

99 299 at 1:25 pm

SEP - 9 1999

Deborah Six
REGISTER OF DEEDS

Register of Deeds Stamp & File Number

- 1. Public Land Survey T 24N R 13W I-01
2. Property Controlling in Section S T R
3. Miscellaneous Property in Section S T R

- 4. Lot No. , Recorded Plat
5. Private Claims

Grid table with columns A-M and rows 2-13. A dot is marked in the intersection of column I and row 2.

I, John C. Schulke, in a field survey on May 26th, 19 99, do hereby certify that under requirements of P.A. 74, Michigan P.A. of 1970, the corner points mentioned in lines 1 and 2 above were in conformance with regulations and rules therefore as required in the current manual of survey instructions of the United States Department of the Interior, Bureau of Land Management or by a decree of a Court of Law and/or that the corner points mentioned in lines 3, 4 and 5 above were in conformance with the rules of the Michigan Board of Professional Surveyors or by a Decree of a Court of Law; established, re-established, monumented, re-monumented, recovered, found as expressed below:

NOTE: Not more than 4 corners, all in the same town and range, may be recorded on this certificate.

A. Description of original monument and accessories and/or subsequent restoration:

I-01 Closing Corner of Sections 2 and 3, T24N, R13W and Standard Corner of Sections 34 and 35 T25N, R13W.

- 1838 John Brink US Deputy Surveyor Set Post.
(1) W. Ash 11" N 37° W 47 links (31.0')
(2) Hemlock 10" N 36° E 21 links (13.9')
1839 John Brink on line between Sec 2 and 3 at 84.52 chains intersected North Boundary at post.
(3) Sugar Maple 12" S 46 1/2° E 33 links (21.8')
(4) Hemlock 10" S 75° W 35 links (23.1')

- 1903 J H Millard, Book B, Pages 76 and 77 found iron and snag of Hemlock BT.
(5) Sugar Maple 10" S 22° E 51 links (33.7')
(6) Sugar Maple 5" S 12° W 91 links (60.1')
No date, Book 2, Page 18, Benzie Co. Surveyor's Book. "set by remains of original bearing trees." No new references Book A, Page 247, monument 1 1/2" Iron Pipe.
1985 Working drawing by Gourdie Fraser of Section 35 shows I-1 with a distance to East to J-1 as 2647.79 feet.

B. Description of corner evidence found and/or method applied in restoring or reestablishing corner:

I-01 Closing Corner of Sections 2 and 3, T24N, R13W and Standard Corner of Sections 34 and 35 T25N, R13W.

Found capped 1/2" by 18" capped rebar by G. F. De La Mater RLS 13030. BTs 1, 2, 3, 4, 5 and 6 are gone. Found four trees being used as bearing trees, see part C. Not able to obtain corner records for these BTs. Two track running NS 11 feet East. Paved Road curving to NW is 300± to the North of corner.


Corner I-01 ratified by the Manistee County Peer Group according to the county plan adopted pursuant to P.A. 345 of 1990, as amended, (being the State Survey and Remonument Act, MCL 54.261 et. seq.). Date of Peer Review: Anthony M. Sawinski June 6, 1999

C. Description of monument for corner and accessories established to perpetuate locating the position of the corner:

I-01 Closing Corner of Sections 2 and 3, T24N, R13W.

Accepted the recovered rebar as the best available evidence of the position of the original corner and on May 26th, 1999 replaced with a Standard Manistee County monument. References:

- (7) Sugar Maple 12" S 17° W 13.39 feet (fd. nail W)
(8) Red Oak 15" S 59° W 34.48 feet (fd. nail SE)
(9) Sugar Maple 5" N 74° W 6.90 feet (fd. nail S)
(10) Twin Ash 16" N 44° W 19.13 feet (fd. nail SW)
(11) USGS Bench Mark N 48° W 46.33 feet (center point)

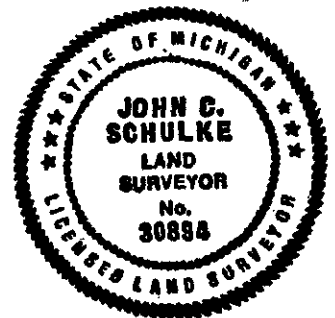

Signed by John C. Schulke
Surveyor's Michigan License No. 30894

Date July 6th, 1999