

DIG 2 3 1998

LAND CORNER RECORDATION CERTIFICATE

Filing Requirement of Act 74, Mich. P.A. 1970

For corners in Manistee County (County)

SECTION

Located In:

Corner Code #

- 1. Public Land Survey T 24N R 13W M-9
2. Property Controlling in Section S T R
3. Miscellaneous S T R
Property in Section S T R

REGISTER'S OFFICE MANISTEE COUNTY

98-251 at 3:40pm JUL 01 1998

Richard S. [Signature]

REGISTER OF DEEDS

Register of Deeds Stamp & File Number

- 4. Lot No. , Recorded Plat
5. Private Claims

Grid table with columns A-M and rows 2-13. Contains numbers 1-36 in a grid pattern.

John C. Schulke, in a field survey on May 21st, 1998

do hereby certify that under requirements of P.A. 74, Michigan P.A. of 1970, the corner points mentioned in lines 1 and 2 above were in conformance with regulations and rules therefore as required in the current manual of survey instructions of the United States Department of the Interior, Bureau of Land Management or by a decree of a Court of Law and/or that the corner points mentioned in lines 3, 4 and 5 above were in conformance with the rules of the Michigan Board of Professional Surveyors or by a Decree of a Court of Law; established, re-established, monumented, re-monumented, recovered, found as expressed below:

NOTE: Not more than 4 corners, all in the same town and range, may be recorded on this certificate.

A. Description of original monument and accessories and/or subsequent restoration:


M-9 Southeast Corner of Section 24, T24N, R13W

- 1838 John Brink US Deputy Surveyor Set Wood Post. References: Beech 9" N44°W 20 links (1) Beech 9" S52.5°W 10 links (2) 1839 J. Brink added two BT: Sugar 10" S28°E 49 links (3) Beech 12" N49°E 31 links (4) 1915 W. Johnson gas pipe, Wexford Co. Surveyors Book 2 Page 113. References: Fence Post S46°W 46 feet (5) Basswood 24" N13°E 139.2 feet (6) 1994 LCRC by R. Mitchell (Survey in 1987) Liber 4, Page 267 Wexford Co. "Found 1 ft. long rust vein in road subsurface from Johnson survey" (measured from witnesses 5 & 6). Set 1/2" rod w. cap # 28417 in CL of roads N, S, E & W. References: Basswood 50" N13°E 141.18 feet (6) Fence post remains S46°W 46 feet (5) Maple 24" S50°E 82.93 feet (7)

B. Description of corner evidence found and/or method applied in restoring or reestablishing corner:

M-9 Southeast Corner of Section 24, T24N, R13W

Found monument described by R. Mitchell. References 1-5 are gone. BT 6 & 7 found in good condition (see part C). Found two other references used by others (see part C, ref 8 & 9).

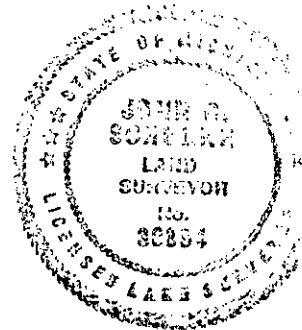

C. Description of monument for corner and accessories established to perpetuate locating the position of the corner:

M-9 Southeast Corner of Section 24, T24N, R13W

Accepted the Mitchell rebar as the best available evidence of the position of the original corner and set a Standard Manistee County monument stamped to identify the corner in a monument box. References:

- Basswood 47" N19°E 140.13 feet Set # 60 nail SE side (6)
Sugar Maple 34" S39°E 82.95 feet Set # 60 nail NE side (7)
Power Pole S88°W 158.34 feet Fd nail, S side (8)
Corner Fence Post S50°W 54.90 feet Fd nail, SE side (9)
Sugar Maple 34" S27°E 93.45 feet Set # 60 nail SW side (10)

Signed by John C. Schulke

Date June 1st, 1998

Surveyor's Michigan License No. 30894

Corner 21-27 raised by the Manistee County Peer Group according to the county plan adopted pursuant to P.A. 345 of 1990, as amended, (being the State Survey and Monument Act, MCL 54.261 et. seq.). Date of Peer Review: Anthony M. [Signature]