

**SURVEY & REMONUMENTATION**

MAR 06 1998

LIBR 2050 PAGE 792

**LAND CORNER RECORDATION CERTIFICATE**  
Filing Requirement of Act 74, Mich. P.A. 1970

STATE OF MICHIGAN  
COUNTY OF MUSKEGON  
REC'D FEB 22 PM 3:06  
*Carroll Carter*  
REGISTER OF DEEDS

SECTION  
Muskegon County  
#

Located in: Corner Code

1. Public Land Survey T 10N R 17W F-3  
T \_\_\_\_\_ R \_\_\_\_\_  
T \_\_\_\_\_ R \_\_\_\_\_  
T \_\_\_\_\_ R \_\_\_\_\_
2. Property Controlling S \_\_\_\_\_ T \_\_\_\_\_ R \_\_\_\_\_
- in Section S \_\_\_\_\_ T \_\_\_\_\_ R \_\_\_\_\_
3. Miscellaneous S \_\_\_\_\_ T \_\_\_\_\_ R \_\_\_\_\_  
Property in Sec. S \_\_\_\_\_ T \_\_\_\_\_ R \_\_\_\_\_
4. Lot No. \_\_\_\_\_, Recorded Plat \_\_\_\_\_
5. Private Claims \_\_\_\_\_

Register of Deeds Stamp & File Number

	A	B	C	D	E	F	G	H	I	J	K	L	M
2	6	5	4	3	2	1							
3													
4	7	8	9	10	11	12							
5													
6	18	17	16	15	14	13							
7													
8	19	20	21	22	23	24							
9													
10	30	29	28	27	26	25							
11													
12	31	32	33	34	35	36							
13													

I, Donald G. Sandel, in a field survey on June 27, 1997 hereby certify that under requirements of P.A. 74, Michigan P.A. of 1970, the corner points mentioned in lines 1 and 2 above were in conformance with regulations and rules therefore as required in the current manual of survey instructions of the United States Department of the Interior, Bureau of Land Management or by a decree of a Court of Law and/or that the corner points mentioned in lines 3, 4 and 5 above were in conformance with the rules of the Michigan Board of Land Surveyors or by a Decree of a Court of Law, established, re-established, monumented, re-monumented, recovered, found as expressed below:

NOTE: Not more than 4 corners, all in the same town and range, may be recorded on this certificate.

A. Description of original monument and accessories and/or subsequent restoration:


- (1) GLO: Set Quarter section post, June 02, 1837.  
B. Oak 15° S13°W 0.18 chains  
W. Oak 6° N15°E 0.09 chains
- (2) Muskegon County Road Commission; Donald W. Schiele #23517, April 1980:  
Found iron in monument box: NE Power Pole 41.75'  
SE 18" Oak 69.10'  
SW 20" Oak 67.49'  
NW 24" Oak 66.51'

B. Description of corner evidence found and/or method applied in restoring or reestablishing corner:

- (1) Found 1 1/2" pipe 24" long in monument box at the intersection of Peterson Road(N/S) and Giles Road (EW). Used existing witnesses to verify corner location.
- (2) Historical usage, documentation, and evidence of corner location reviewed and ratified by the Muskegon County Peer Group, June 17, 1997.

C. Description of monument for corner and accessories established to perpetuate locating the position of the corner:

- Set 3"dia. x 31" Cast Iron "County Survey" monument in place of found 1 1/2" pipe;  
Witnessed as follows:
- |                          |              |        |
|--------------------------|--------------|--------|
| N50°E found nail SE side | Utility Pole | 41.77' |
| S53°E set nail NE side   | Utility Pole | 55.34' |
| S29°E found nail NW side | Utility Pole | 52.40' |
| S34°W set nail NW side   | 20" Oak      | 64.14' |
| S46°W found nail NE side | Utility Pole | 44.95' |
| N41°W found nail SE side | 24" Oak      | 65.28' |

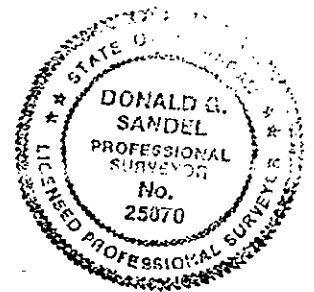

Signed by Donald G. Sandel  
Surveyor's Michigan License No. 25870

Date 5 December 1997

A1K79