

1994 DEC 29 AM 10:15

LAND CORNER RECORDATION CERTIFICATE
Filing Requirement of Act 74, Mich. P.A. 1970

For corners in

Muskegon Located In: Corner Code #/

- 1. Public Land Survey T 11 R 17 SURVEY & REMONUMENTATION
- 2. Property Controlling in Section S ___ T ___ R ___ APR 28 1995
- 3. Miscellaneous Property in Sec. S ___ T ___ R ___ COMMISSION

Carrie Carter
REGISTER OF DEEDS

Seq. #1

A1617

SURVEY & REMONUMENTATION

MAR 06 1998

Register of Deeds Stamp & File Number
SECTION

- 4. Lot No. _____, Recorded Plat _____
- 5. Private Claims _____

I, Stephen V. Vallier field survey on December, 1994, do hereby certify that under requirements of P.A. 74, Michigan P.A. of 1970, the corner points mentioned in lines 1 and 2 above were in conformance with regulations and rules therefore as required in the current manual of survey instructions of the United States Department of the Interior, Bureau of Land Management or by a decree of a Court of Law and/or that the corner points mentioned in lines 3, 4 and 5 above were in conformance with the rules of the Michigan Board of Land Surveyors or by a Decree of a Court of Law; established, re-established, monumented, re-monumented, recovered, found as expressed below:

	A	B	C	D	E	F	G	H	I	J	K	L	M
2	6	5	4	3	2	1							
3													
4	7	8	9	10	11	12							
5													
6	18	17	16	15	14	13							
7													
8	19	20	21	22	23	24							
9													
10	30	29	28	27	26	25							
11													
12	31	32	33	34	35	36							
13													

NOTE: Not more than 4 corners, all in the same town and range, may be recorded on this certificate.

A. Description of original monument and accessories and/or subsequent restoration:

- 1837 GLO set corner
- 1950's M.C.R.C. Tie Map - 2" stake
- 1984 C.F. Lewandowski L.C.R.C. Liber 1283 page 379 - Found 1" iron pipe in monument box. Reset with 2 3/4" x 30" cast iron monument in monument box.

B. Description of corner evidence found and/or method applied in restoring or reestablishing corner:

Found 2 3/4" cast iron monument with County Survey Cap in monument box. Accepted position of corner due to evidence of Historical usage and consistent documentation.


POSITION OF SAID
RECORDED CORNER
REVIEWED & RATIFIED
BY MUSKEGON COUNTY
PEER GROUP IN ACCORDANCE
WITH P.A. 345, OF 1990

Apr 20, 1993

C. Description of monument for corner and accessories established to perpetuate locating the position of the corner:

2 3/4" cast iron monument with County Survey Cap in monument box.

- N 35 deg E 57.32' 14" oak with nail
- N 50 deg E 80.50' 12" oak with nail
- S 40 deg E 66.45' 10" oak with nail
- S 10 deg W 75.00' 14" oak with nail
- S 45 deg W 56.75' 14" oak with nail

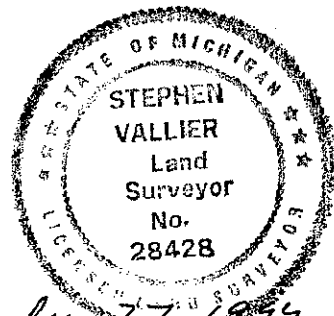

Signed by *Stephen Vallier* Date *Dec 27, 1994*

Surveyor's Michigan License No. 28428