

STATE OF MICHIGAN  
COUNTY OF MUSKOGON  
RECEIVED FOR RECORD

LAND CORNER RECORDATION CERTIFICATE  
Filing Requirement of Act 74, Mich. P.A. 1970

1994 DEC 29 AM 10:15

For corners in

Muskegon (County) Located In: Corner Code #

- 1. Public Land Survey T 11 R 17 K-9  
T \_\_\_\_\_ R \_\_\_\_\_ SURVEY &  
T \_\_\_\_\_ R \_\_\_\_\_ REMONUMENTATION  
T \_\_\_\_\_ R \_\_\_\_\_
- 2. Property Controlling S \_\_\_\_\_ T \_\_\_\_\_ R \_\_\_\_\_  
in Section S \_\_\_\_\_ T \_\_\_\_\_ R \_\_\_\_\_ APR 28 1995
- 3. Miscellaneous S \_\_\_\_\_ T \_\_\_\_\_ R \_\_\_\_\_  
Property in Sec. S \_\_\_\_\_ T \_\_\_\_\_ R \_\_\_\_\_ COMMISSION

*Carrie Carter*  
REGISTER OF DEEDS

Register of Deeds Stamp & File Number

- 4. Lot No. \_\_\_\_\_, Recorded Plat \_\_\_\_\_
- 5. Private Claims \_\_\_\_\_

	A	B	C	D	E	F	G	H	I	J	K	L	M
2	6	5	4	3	2	1							
3													
4	7	8	9	10	11	12							
5													
6	18	17	16	15	14	13							
7													
8	19	20	21	22	23	24							
9													
10	30	29	28	27	26	25							
11													
12	31	32	33	34	35	36							
13													

I, Stephen V. Vallier field survey on December, 19 94, do hereby certify that under requirements of P.A. 74, Michigan P.A. of 1970, the corner points mentioned in lines 1 and 2 above were in conformance with regulations and rules therefore as required in the current manual of survey instructions of the United States Department of the Interior, Bureau of Land Management or by a decree of a Court of Law and/or that the corner points mentioned in lines 3, 4 and 5 above were in conformance with the rules of the Michigan Board of Land Surveyors or by a Decree of a Court of Law; established, re-established, monumented, re-monumented, recovered, found as expressed below:

NOTE: Not more than 4 corners, all in the same town and range, may be recorded on this certificate.

A. Description of original monument and accessories and/or subsequent restoration:

- 1837 GLO set Corner
- 1950's M.C.R.C Tie Map - witnesses only
- 1983 C.F Lewandowski - L.C.R.C. Liber 1260 Page 164 - Found 1/2" Iron Pipe along side 1" pipe. Reset with 4" x 30" Cast Iron Monument with County Survey Cap.

B. Description of corner evidence found and/or method applied in restoring or reestablishing corner:


Found 4" Cast Iron Monument with County survey Cap.  
Accepted position of corner due to evidence of Historical usage and consistent documentation.

POSITION OF SAID  
RECORDED CORNER  
REVIEWED & RATIFIED  
BY MUSKOGON COUNTY  
PEER GROUP IN ACCORDANCE  
WITH P.A. 345, OF 1990  
*Jan 15 1993*

C. Description of monument for corner and accessories established to perpetuate locating the position of the corner:

4" Cast Iron Monument with County Survey Cap.

- N 60 deg E 48.82' Light Pole with Nail
- S 25 deg W 65.91' Telephone Pole with nail
- N 35 deg W 65.72' 10" Oak with nail
- S 60 deg E 72.61' Telephone Pole with nail

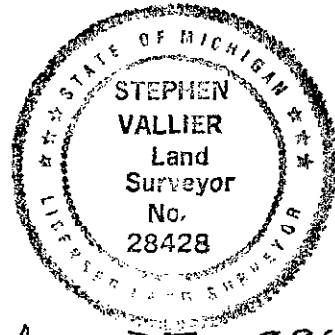

Signed by *Stephen Vallier* Date *Dec 27, 1994*  
Surveyor's Michigan License No. 28428