

MICHIGAN
DEPARTMENT OF CONSERVATION
FORESTRY DIVISION

LAND CORNER RECORD

T. 47 N.R. 23N


Marquette COUNTY

DESCRIPTION OF CORNER Sec. Cor. common to Secs. 16-17-20-21

CORNER MONUMENT 1 1/2" x 30" iron pipe buried in E-W road

DATE MONUMENT PLACED AND WITNESSED 4-11-67

WITNESSES TO CORNER..... 8" Hemlock (S21 NBT) S 17°E 41.6'

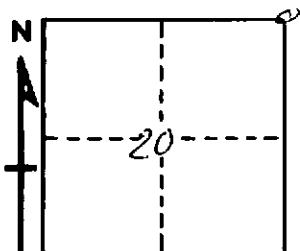

CIRCLE CORNER REGISTERED

AND

DESCRIPTION IN DETAIL AS TO HOW CORNER WAS LOCATED AND IDENTIFIED OR RESTORED.

Found wit: marked by Court, Road Com.

Also found 3/4" iron pipe, N30°E, 30.0' from corner.

SURVEYOR'S SEAL

Billy D. Luckler
SIGNED Billy D. Luckler, R.L.S. DATE 9-20-68
REGISTERED LAND SURVEYOR