

# LAND CORNER RECORDATION CERTIFICATE

Filing Requirement of Act 74, Mich. PA 1970

For Corners In: Montmorency (County)	Located In	Corner Code #	
1. Public Land Survey	T _____ R _____		
	T _____ R _____		
2. Property Controlling in Section	S <u>6</u> T <u>29N</u> R <u>1E</u> <u>14</u>		
	S <u>8</u> T <u>29N</u> R <u>1E</u> <u>14</u>		
3. Miscellaneous Property in Section	S _____ T _____ R _____		
	S _____ T _____ R _____		

Received  
MONTMORENCY COUNTY, MI  
01-24-2012 09:37 am.  
201200049473  
Filed for Record in  
MONTMORENCY COUNTY, MI  
TERESA WALKER, REGISTER OF DEEDS  
01-24-2012 At 09:39:02 am.  
LAND CORNER 14.00  
Liber 1 Page 759 - 759

Instrument 201200049473      Liber Page 1 759


Register of Deeds Stamp & File Number

4. Lot No: \_\_\_\_\_ Recorded Plat: \_\_\_\_\_

5. Private Claims: \_\_\_\_\_

I, Carl T. Kiiskila, in a field survey on August 26, 2011 do hereby state that under requirements of PA 74, Michigan PA of 1970, the corner points mentioned in lines 1 and 2 above were in conformance with regulations and rules therefore as required in the current manual of survey instructions of the United States Department of the Interior, Bureau of Land Management or by a decree of a Court of Law and/or that the corner points mentioned in lines 3, 4 and 5 above were in conformance with the rules of the Michigan Board of Land Surveyors or by a Decree of a Court of Law, established, re-established, monumented, recovered, found as expressed below:

**NOTE: Not more than 2 corners, all in the same town and range, may be recorded on this certificate.**

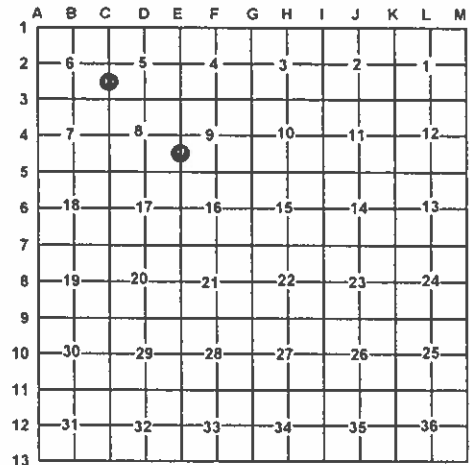

**A. Description of original monument and accessories and/or subsequent restoration:**

- 14- This corner position was not established during the original government survey.
- 16- 1992 Delmer E. Porter L.S. #15410 set this corner while surveying in section 19.

**B. Description of corner evidence found and/or method applies in restoring or re-establishing corner:**

- 14- Established the Northeast corner of the Southeast quarter of the Southeast quarter of section 19 as per B.L.M. instructions for the subdivision of a section.
- 16- Found a 4" concrete monument fitting the standard BLM procedure for subdivision of a section lowered monument to be flush with ground.

**C. Description of monument for corner and accessories established to perpetuate locating the position of the corner:**

- 12- Set 5/8" X 34" iron rod with 2" aluminum cap  
Wit: N07°E 15.40' to set nail & tag W side 9" Sugar Maple  
S71°E 6.60' to set nail & tag N side 6" Sugar Maple  
S38°W 17.13' to set nail & tag W side 11" Ash  
N68°W 5.38' to set nail & tag N side 6" Sugar Maple  
Set blue Carsonite Post North 1'
- 16- Found a 4" concrete monument  
Wit: N55°E 20.48' to set nail & tag S side 10" Cedar  
S36°E 11.83' to set nail & tag W side 10" Cedar  
S11°W 11.25' to set nail & tag NW side 11" Cedar  
N75°W 7.88' to set nail & tag S side 12" Cedar  
Set blue Carsonite Post North 1'

Signed by: Carl T. Kiiskila  
Surveyor's Michigan License No.: 33981

Date: 1-4-12

