

**SURVEY &  
REMONUMENTATION**

**Montmorency County Remonumentation**

APR 24 1995

**LAND CORNER RECORDATION CERTIFICATE**  
Filing Requirement of Act 74, Mich. P.A. 1970

STATE OF MICHIGAN  
MONTMORENCY COUNTY  
Recorded & Filed

For corners in **COMMISSION**  
MONTMORENCY  
(County)

Located In: HILLMAN TWP. Corner Code J-1

10-19-1994 13:50:52

- 1. Public Land Survey T 31N R 4E J-1
- T \_\_\_\_\_ R \_\_\_\_\_
- T \_\_\_\_\_ R \_\_\_\_\_
- T \_\_\_\_\_ R \_\_\_\_\_
- 2. Property Controlling S \_\_\_\_\_ T \_\_\_\_\_ R \_\_\_\_\_
- in Section S \_\_\_\_\_ T \_\_\_\_\_ R \_\_\_\_\_
- 3. Miscellaneous S \_\_\_\_\_ T \_\_\_\_\_ R \_\_\_\_\_
- Property in Sec. S \_\_\_\_\_ T \_\_\_\_\_ R \_\_\_\_\_

**APPROVED BY  
PEER GROUP**

AUG 05 94

*J.B.*

A. PANGAN-MCELROY  
REGISTER OF DEEDS

Liber 00012 Page 0079

Register of Deeds Stamp & File Number

- 4. Lot No. \_\_\_\_\_, Recorded Plat \_\_\_\_\_
- 5. Private Claims \_\_\_\_\_

	A	B	C	D	E	F	G	H	I	K	L	M
2	6	5	4	3	2	1						
3												
4	7	8	9	10	11	12						
5												
6	16	17	18	15	14	13						
7												
8	19	20	21	22	23	24						
9												
10	30	29	28	27	26	25						
11												
12	31	32	33	34	35	36						
13												

I, FREDERICK J. KING, in a field survey on July 28, 1994, do hereby certify that under requirements of P.A. 74, Michigan P.A. of 1970, the corner points mentioned in lines 1 and 2 above were in conformance with regulations and rules therefore as required in the current manual of survey instructions of the United States Department of the Interior, Bureau of Land Management or by a decree of a Court of Law and/or that the corner points mentioned in lines 3, 4 and 5 above were in conformance with the rules of the Michigan Board of Land Surveyors or by a Decree of a Court of Law; established, re-established, monumented, re-monumented, recovered, found as expressed below:

**NOTE: Not more than 4 corners, all in the same town and range, may be recorded on this certificate.**

**A. Description of original monument and accessories and/or subsequent restoration:**

**J-1 NORTH 1/4 CORNER, SECTION 2**

- July 1855 - Original Corner Set by Butler Ives, D.S. N48E - Dead Cedar - 17.16' (26 lks)
- S78W - Dead Hemlock - 11.88' (18 lks)
- Mar. 1973 - Act #74 Rec Bk 1, Pg 60 by D.E. Porter, N50W - Fnc Cor Post - 48.48'
- PS #15410 - Set 1/2" & RLS Cap in Mon Box N50E - Fnc Cor Post - 60.03'
- by Sngl Prop between I-1 & K-1 S10W - 3" W Pine - 54.87'

NO ACT #132 FOUND RECORDED FOR THIS CORNER.

**B. Description of corner evidence found and/or method applied in restoring or reestablishing corner:**

**J-1 NORTH 1/4 CORNER, SECTION 2**


- 7-28-94 - Fnd Rec 1/2" Iron & Cap #15410 S10°W - 54.5' (R-54.87') Rec W Pine (1973)
- in Mon Box in C.L. E-W Pymt N50°W - 48.70' (R-48.48') Fnd Tag #15410 in Fnc Cor Post
- N50°E - ±60' (R-60.03') - Fnd Tag #15410 in Broken Fnc Cor Post

No 1855 Wit Fnd.

This Corner Approved by County Peer Review on Aug. 5, 1994 as a careful and faithful establishment of the position of the corner.

**C. Description of monument for corner and accessories established to perpetuate locating the position of the corner:**

- J-1 7-28-94 Placed Co Re-Mon Cap on Iron Fnd in Mon Box
- Cor is in C.L. of E-W B.T. Rd (Anchor Lake Rd)
- Cor is ±37' E of Fnc to N & ±18' E of Fnc to S
- North - 18.2' - Set Treated 2"x4"
- N30°E - 36.89' - Set Tag W side of W Tree Tri -Box Elder Clump
- N50°E - ±60' - Fnd Tag #15410 in Broken Fnc Cor Post
- S10°W - 54.53' - Set Tag in E side 24" W Pine
- S30°W - 37.82' - Set Tag in SE side Fnc Cor Post
- N50 W - 48.70' - Set Tag in SW side Fnc Cor Post

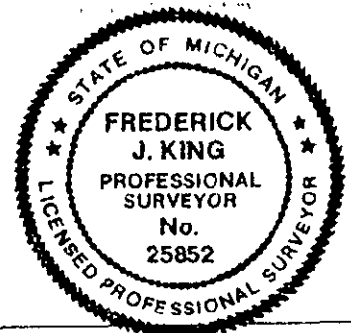

Signed by Frederick J. King

Date 10-18-94

Surveyor's Michigan License No. 25852